


Rice

KANSAS

Section 28 Township 18 Range 6-W

Well No. #1 Wilkens

Company Ackely, Holl et al

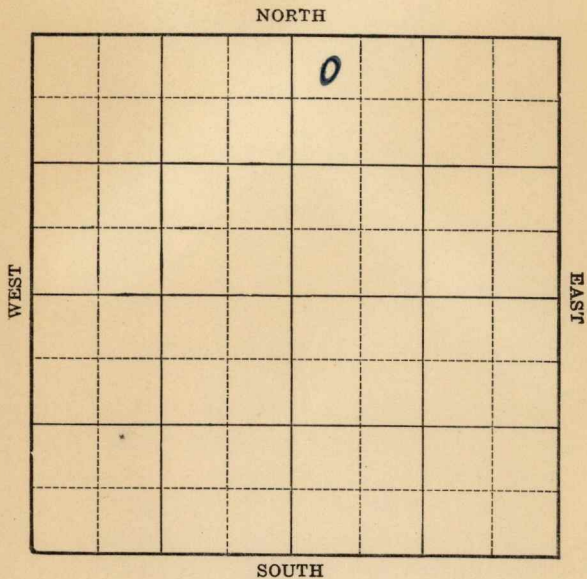

Map No. 44 Sec. 28 Twp. 18 R. 6W

Well No. 1 Wilkens

Ackely, Holl etal Company


Contractor

FIRST REPORT

SECTION PLAT

NW NE

440 Ft. from N. Line

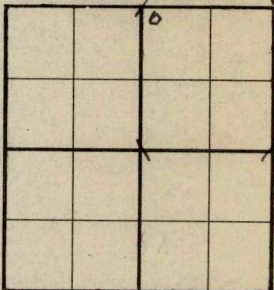

_____ Ft. from S. Line

_____ Ft. from E. Line

440 Ft. from W. Line

WILDCAT

Location _____

RECORD

Cased _____ in., _____ ft.

Sand _____

Gas _____

Oil _____

Total Depth _____

Rig up _____

Drilling and Remarks:

Derrick

PRODUCTION

1st 24 hrs. Nat. _____

1st 24 hrs. after shot _____

Gas _____ Cu. Ft.

Dry Hole _____

Abandoned _____

Date

APR 3 1940

19

S. J. LEWIS Scout

Map No. 44 Sec. 28 Twp. 18 R. 6W

Well No. 1 Wilkens

Ackely, Holl etal Company

Contractor

ABANDONED

NW NE

SECTION PLAT

440 Ft. from N. Line

		0	

_____ Ft. from S. Line

_____ Ft. from E. Line

440 Ft. from W. Line

WILDCAT

Location _____

RECORD

Rig up _____

Cased _____ in., _____ ft.

Drilling and Remarks:

Sand _____

Cong 3375.

Gas _____

5409285

Oil _____

1100 acid

Total Depth 3514

No show.

PRODUCTION

1st 24 hrs. Nat. _____

1st 24 hrs. after shot _____

Gas _____ Cu. Ft.

Dry Hole _____

Abandoned _____

Date

MAY 15 1940

S. J. LEWIS Scout