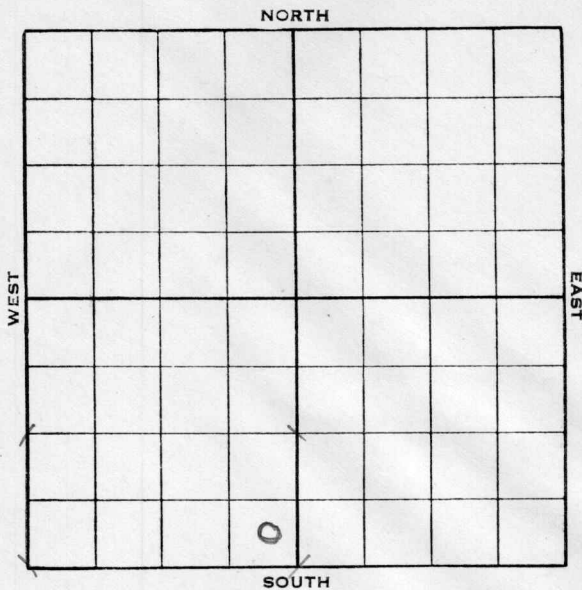



Barton

KANSAS

Section 1 Township 20 Range 11-WWell No. 3 SteckelCompany Bennett

Sec. 1 Twp. 20 R. 11-WWell No. #3 Steckel Farm
Bennett Company Ft. from N. Line330 Ft. from S. Line330 Ft. from E. Line Ft. from W. Line

Elev. 1761

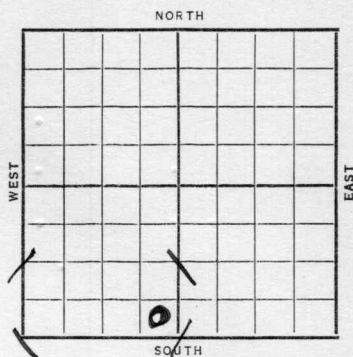

Date	REPORT
1938	
2/9	Cellar.
2/18	B. C. R.
2/26	C. R.
3/4	R. U.
3/11	"
3/18	15" @ 100'. 12" @ 480'. Drlg. 485'.
3/25	Drlg. 1675'.
4/1	10" @ 1851'. Drlg. 2150'.
4/8	SD 2475'.
4/15	" "
4/22	8" @ 2396'. Fsg. 2480'.
4/29	Fsg. 2480'.
5/6	8" @ 2423'. T.D. 2610'. Rng. 6"
5/12	6" @ 2605'. S.O. 2985-90'. Drlg. 3120'.
5/20	Arb. 3271'. 5" @ 3273'. T.D. 3284'. 600' oil.
	OVER

1938

5/25

5" @ 3273'.

Arb. 3271'.

T.D. 3284'.

2000 acid.

Potential 1185 bbls.

COMPLETED

Barton KANSASMap No. _____ Sec. 1 Twp. 20 R. 11WWell No. 3 SteckelBennett

Company _____

Contractor _____

FIRST REPORT


SE SW

_____ Ft. from N. Line

330 Ft. from S. Line330 Ft. from E. Line

_____ Ft. from W. Line

SECTION PLAT

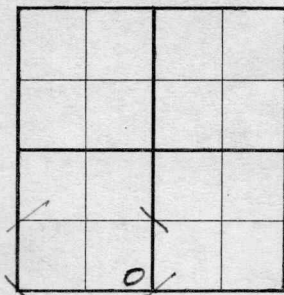

Location _____

Rig up _____

Drilling and Remarks:

cellar

RECORD

Cased _____ in., _____ ft.

Sand _____

Gas _____

Oil _____

Total Depth _____

PRODUCTION

1st 24 hrs. Nat. _____

1st 24 hrs. after shot _____

Gas _____ Cu. Ft.

Dry Hole _____

Abandoned _____

Date

FEB 9 1938 19

H. D. Hatfield

Scout

Barton

KANSAS

Map No. 46 Sec. 1 Twp. 20 R. 11WWell No 3 SteckelBennett

Company

Contractor

COMPLETED
SE SW Ft. from N. Line330 Ft. from S. Line330 Ft. from E. Line Ft. from W. Line**SECTION PLAT**

0

Location Rig up

Drilling and Remarks:

*2000 acid**POT 1185***RECORD**Cased 5 in., 3273 ft.Sand Arb 3271Gas Oil Total Depth 3284**PRODUCTION**1st 24 hrs. Nat. 1st 24 hrs. after shot Gas Cu. Ft.Dry Hole Abandoned

Date

MAY 25 1938

19

H. D. Hatfield Scout