


Barton

Map No. KANSAS Sec. 8 Twp. 20 R. 11W

Well No. 3-Steckel Farm
Magnolia Company

NORTH

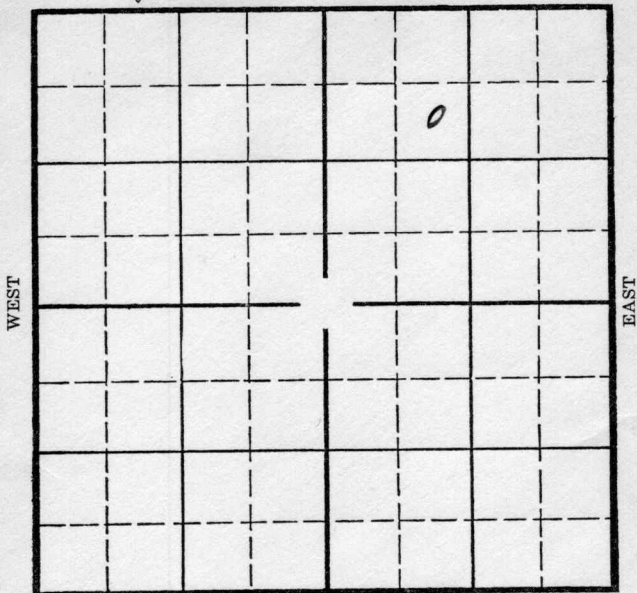

SOUTH

O. W. D. D.

Location _____

Drilling Remarks _____

Rig Up _____

Drilling Remarks _____

RECORD

Cased _____ in. _____ ft.

Sand _____

Gas _____

Oil _____

Total Depth _____

PRODUCTION

1st 24 hrs. Nat. _____

1st 24 hrs. after shot _____

Gas _____ cu. ft. _____

Dry Hole _____


Abandoned _____

Barrow

Map No. KANSAS Sec. 1 Twp. 20 R. 11W

Well No. 3-Steckel Farm _____
Magrolin Company _____

990 Ft. from N. Line
____ Ft. from S. Line
____ Ft. from E. Line
990 Ft. from W. Line
Elev. 1764

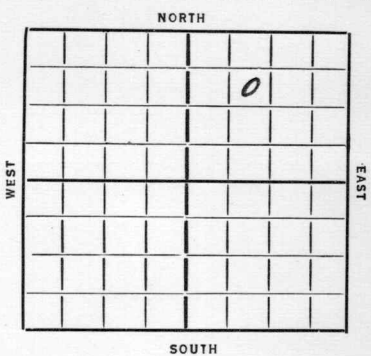

REPORT O. W. D. D

Date	Description
12/14	Cellar
12/19	Dly 125
12/26	" 1905
1/1/36	Top Siliceous 3282 TD 3285
1/7	Rung 7" org 3282 (Tel) TD 3288
1/9	Swabbed 24 Bbls per hr for 7 hrs Natural (Tel)
1/9	Swabbed 36 Bbls per hr for 12 hrs
1/10	TD 3291 Rung tubing to & well acidize (Tel)
1/10	Top Sil & 7" 3282 3700' Oil 10 hrs
1/17	Swabbed 25 Bbls Oil P/H for 17 hrs off Btm. TD 3289
1/17	TD 3291 Swabbed 35 Oil P/H 1000 acid
	Pumped 379 Oil 24 hrs Ficting

OVER

1/22 Sil 3282
TD 3291
1000 acid
379 bbls.

COMPLETED

1936

O. W. D. D

2/26 Run to deepens.

3/6 TD 3299

Swabbing 15 bbls per hr.

3/13 Runny tubing

3/20 T.D. 3307 Est. 20 bbls. per hour.

3/27- Pumped 330 bbls in 18 hrs on potential.

4/2- -

4/1 TD 3307

378 bbls.

COMPLETED

Map No. 46 Sec. 1 Twp. 20 R. 11W

Well No. 3 - Steckel

Magnolia Company

Contractor

FIRST REPORTS

SECTION PLAT

		o	

990 Ft. from N. Line

..... Ft. from S. Line

..... Ft. from E. Line

990 Ft. from W. Line

Location.....

Rig up.....

Drilling and Remarks:

Cellar

RECORD

Cased..... in., ft.

Sand.....

Gas.....

Oil.....

Total Depth.....

PRODUCTION

1st 24 hrs. Nat.....

1st 24 hrs. after shot.....

Gas..... Cu. Ft.

Dry Hole.....

Abandoned.....

Date

12-11-35 192..... Scout

ORVAL MANNSCHRECK

Map No. 46 Sec. 1 Twp. 20 R. 11W

Well No. 3-Steckel

Magnolia Company

Contractor

SECTION PLAT

990 Ft. from N. Line

..... Ft. from S. Line

..... Ft. from E. Line

990 Ft. from W. Line

		0	

COMPLETED

Location.....

Rig up.....

Drilling and Remarks:

1000 acid

374 bbls

RECORD

Cased..... in., ft.

Sand S/L 3282

Gas.....

Oil.....

Total Depth 3291

PRODUCTION

1st 24 hrs. Nat.....

1st 24 hrs. after shot.....

Gas..... Cu. Ft.

Dry Hole.....

Abandoned.....

Date

JAN 22 1936

192.....

Scout

ORVAL MANN SCHRECK

Map No. 46 Sec. 1 Twp. 20 R. 11W

Well No. 3-Steckel

Magnolia Company

Contractor

FIRST REPORT

SECTION PLAT

990 Ft. from N. Line

..... Ft. from S. Line

..... Ft. from E. Line

990 Ft. from W. Line

		0	

OWDD

Location.....

Rig up.....

Drilling and Remarks:

O.T.D. 3291

Rign up to
deeper

RECORD

Cased..... in., ft.

Sand.....

Gas.....

Oil.....

Total Depth.....

PRODUCTION

1st 24 hrs. Nat.....

1st 24 hrs. after shot.....

Gas..... Cu. Ft.

Dry Hole.....

Abandoned.....

Date

FEB 26 1936 192.....

ORVAL MANNSCHRECK

Scout

Map No. 46 Sec. 1 Twp. 20 R. 11^w

Well No. 3-F. Steckel

Magnolia Company

Contractor

COMPLETE

SECTION PLAT

		0	

990 Ft. from N. Line

..... Ft. from S. Line

..... Ft. from E. Line

990 Ft. from W. Line

owd

Location.....

Rig up.....

Drilling and Remarks:

378 bbls

RECORD

Cased..... in., ft.

Sand.....

Gas.....

Oil.....

Total Depth. 3307.

PRODUCTION

1st 24 hrs. Nat.....

1st 24 hrs. after shot.....

Gas..... Cu. Ft.

Dry Hole.....

Abandoned.....

Date

ORVAL MANNSCHRECK

4-1-36 192.....

Scout