KANSAS


FORM 51 5M 6-46 PETROL

Rice

Section 21 Township 18 Range 9W

Well No. 1 Schoonover

Company Phil-Han

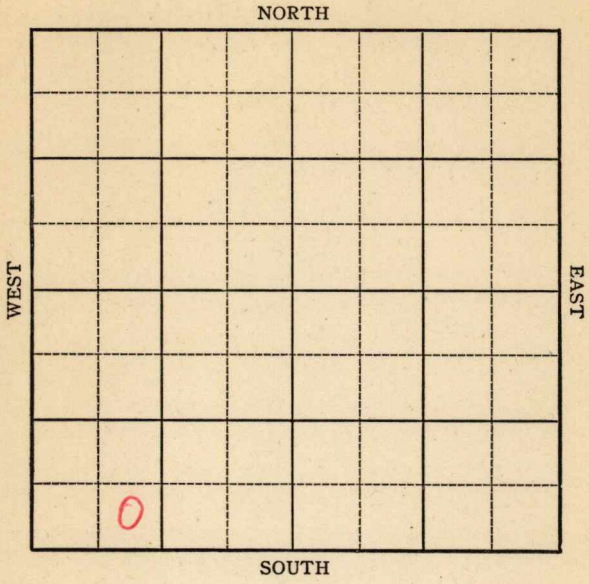

FORM 252-A
5M 6-46 PETROL

KANSAS Rice County ✓

Sec. 21 Twp. 18 R. 9W

Well No. #1 Schoonover Farm

Phil-Han Company

Wildcat


Ft. from N. Line

330 Ft. from S. Line

Ft. from E. Line

990 Ft. from W. Line

SE SW SW

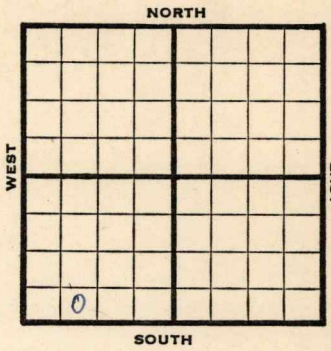


1946 Elev. 1723 REPORT

7/3 Location

7/9 8 5/8" @ 220
Drlg 2300'

7/16 Lans 2886
Arb 3242
TD 2344
5" @ 3243 RUST

7/23 TD 3258
20 qts Bail 3/4 bbl oil PH

7/31 Arb. 3242
5" @ 3243
Shot off shoe
TD 3258'

ABANDONED

FORM 26 200 BKS 2-44 PETROL

KANSAS

Kansas Pool Name Wildcat

Map No. 46 Sec. 21 Twp. 18 R. 9W


Well No. 1 Schoonover

Phil-Han Company

FIRST REPORT Contractor

SE SW SW

SECTION PLAT

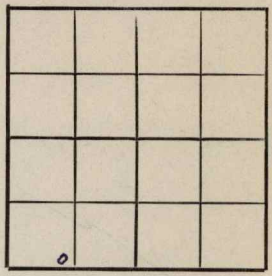

____ Ft. from N. Line

330 Ft. from S. Line

____ Ft. from E. Line

990 Ft. from W. Line

Rice County

Location x

Rig up

Drilling and Remarks:

RECORD

Cased ____ in., ____ ft.

Sand

Gas

Oil

Total Depth

PRODUCTION

1st 24 hrs. Nat.

1st 24 hrs. after shot

Gas ____ Cu. Ft.

Dry Hole

Abandoned

Date

JUL 3 1946 19

S. J. LEWIS Scout

FORM 56 200 BKS, 1-44 PETROL

KANSAS Kansas Pool Name Wildcat

Map No. Sec. 21 Twp. 18 R. 9W

Well No. 1 Schoonover


Phil-Han Company

ABANDONED Contractor

SE SW SW

E 1,1723

SECTION PLAT

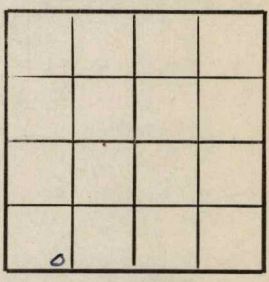

Ft. from N. Line

330 Ft. from S. Line

Ft. from E. Line

990 Ft. from W. Line

Rice County

Location

Rig up

Drilling and Remarks:

RT 3242
5" @ 3243
shut off shoe

RECORD

Cased in., ft.

Sand

Gas

Oil

Total Depth 3258

PRODUCTION

1st 24 hrs. Nat.

1st 24 hrs. after shot

Gas Cu. Ft.

Dry Hole

Abandoned

Date

JUL 3 1 1946 19

S. J. LEWIS Scout