

KANSAS

Barton

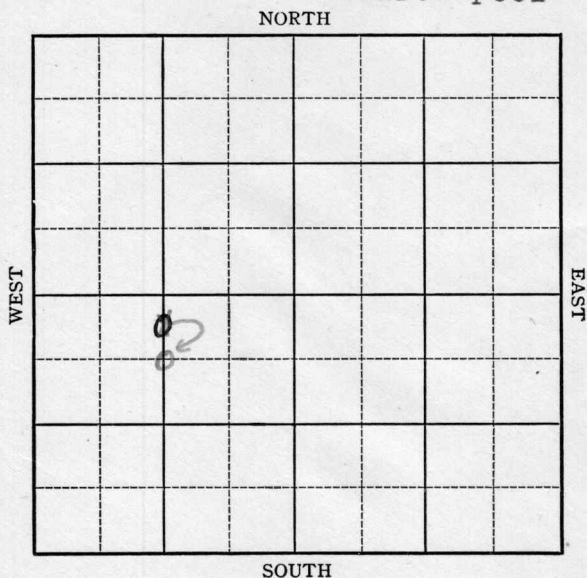
FORM 51 5M 4-41 PETROL

Section 1 Township 20 Range 11-W

Well No. 4 Steckel

Company C. H. Lebow

Silica pool



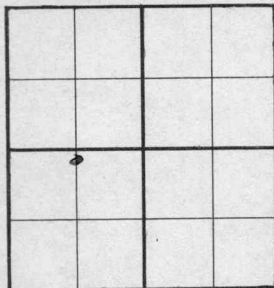
Map No. 46 Sec. 1 Twp. 20 R. 11WWell No. 4 SteckelC. H. Lebow CompanyFIRST REPORT Contractor

C N L SW

330 Ft. from N. Line Ft. from S. Line Ft. from E. Line1320 Ft. from W. Line

SILICA POOL

SECTION PLAT

Location Rig up

Drilling and Remarks:

8" - 133

Anhy. 467

Drlg. 2818

RECORD

Cased in., ft.Sand Gas Oil Total Depth

PRODUCTION

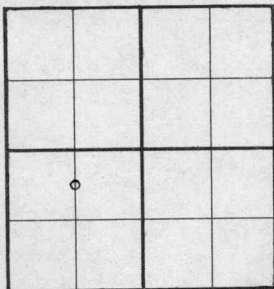
1st 24 hrs. Nat. 1st 24 hrs. after shot Gas Cu. Ft.Dry Hole Abandoned

Date

MAY 27 1941 19S. J. LEWIS Scout

Map No. 46 Sec. 1 Twp. 20 R. 11WWell No. 4 SteckelC. H. Lebow CompanyCORRECTION ContractorC N $\frac{1}{2}$ SW

SECTION PLAT

660 Ft. from N. Line Ft. from S. Line Ft. from E. Line1320 Ft. from W. Line

SILICA POOL

Location Rig up

Drilling and Remarks:

Reported

C N L SW

RECORD

Cased in., ft.Sand Gas Oil Total Depth

PRODUCTION

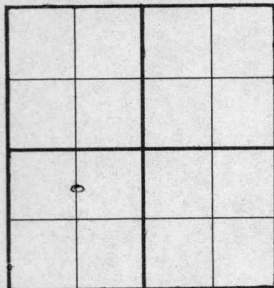
1st 24 hrs. Nat. 1st 24 hrs. after shot Gas Cu. Ft.Dry Hole Abandoned

Date

JUN 4 1941 19 S. J. LEWIS Scout

Map No. 46 Sec. 1 Twp. 20 R. 11WWell No. 4 SteckelC. H. Lebow Company

Contractor

COMPLETED**SECTION PLAT**C N $\frac{1}{2}$ SW660 Ft. from N. Line Ft. from S. Line Ft. from E. Line1320 Ft. from W. Line**SILICA POOL**Location Rig up

Drilling and Remarks:

*CR 3268**5" @ 3268.**2000 acio l**Depth 81123**45° Gr***RECORD**Cased in., ft.Sand Gas Oil Total Depth 3276**PRODUCTION**1st 24 hrs. Nat. 1st 24 hrs. after shot Gas Cu. Ft.Dry Hole Abandoned

Date

JUN 1 1 1941 19S. J. LEWIS Scout