

KANSAS


Barton

FORM 51 5M 4-41 PETROL

Section 1 Township 20 Range 11W

Well No. #5 Steckel

Company Bennett et al

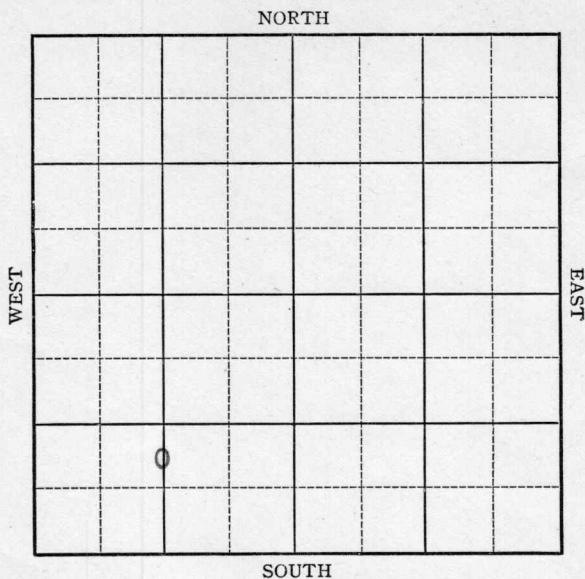

Map No. 46 Sec. 1 Twp. 20 R. 11WWell No. 5 SteckelBennett etal Company

Contractor

FIRST REPORT

C NL S $\frac{1}{2}$ SW

_____ Ft. from N. Line

990 Ft. from S. Line1320 Ft. from E. Line

_____ Ft. from W. Line

SECTION PLAT

SILICA POOL

Location _____

Rig up _____

Drilling and Remarks:

10" @ 113'
S.D. 2732 $\frac{1}{2}$

Repairs _____

RECORD

Cased _____ in., _____ ft.

Sand _____

Gas _____

Oil _____

Total Depth _____

PRODUCTION

1st 24 hrs. Nat. _____

1st 24 hrs. after shot _____

Gas _____ Cu. Ft.

Dry Hole _____

Abandoned _____

Date

SEP 10 1941


19

S. J. LEWIS Scout

Map No. K-46 Sec. 1 Twp. 20 R. 11WWell No. 5 SteckelBennett et al CompanyCOMPLETED ContractorC NL S $\frac{1}{2}$ SW Ft. from N. Line990 Ft. from S. Line1320 Ft. from E. Line Ft. from W. Line

SILICA POOL

SECTION PLAT

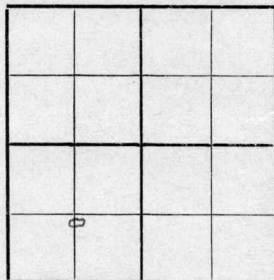Location Rig up

Drilling and Remarks:

As 732687" @ 32701500 ac cuDepth 3260Not 3000450 Gr

RECORD

Cased in., ft.Sand Gas Oil Total Depth 3278

PRODUCTION

1st 24 hrs. Nat. 1st 24 hrs. after shot Gas Cu. Ft.Dry Hole Abandoned

Date

OCT 1 1941 19S. J. LEWIS Scout