
FORM 51

Rice KANSAS

Section 21 Township 18 Range 9 W

Well No. # 1 Schoonover

Company Pickrell Drlg.

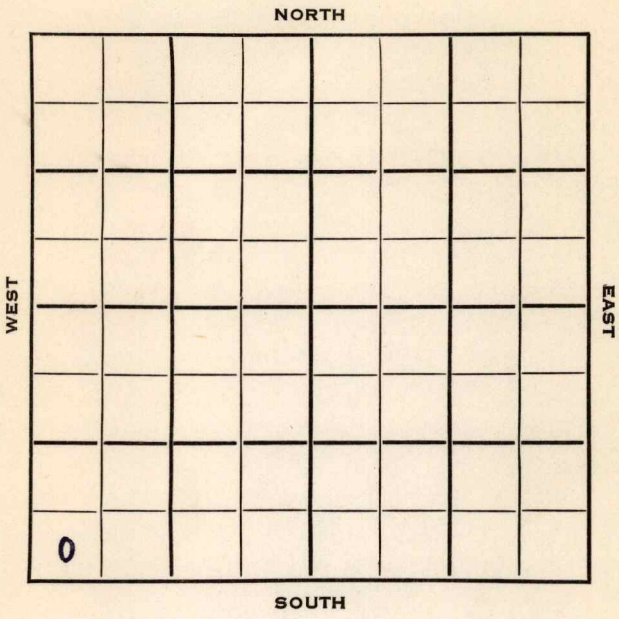

FORM 252-B
10M 8-51 TPCO.

Rice KANSAS ✓

Sec. 21 Twp. 18 R. 9W

Well No. #1 Schoonover Farm

Pickrell Drlg. Company

Pickrell Drlg. Contractor


Ft. from N. Line

330 Ft. from S. Line

Ft. from E. Line

330 Ft. from W. Line

SW SW SW

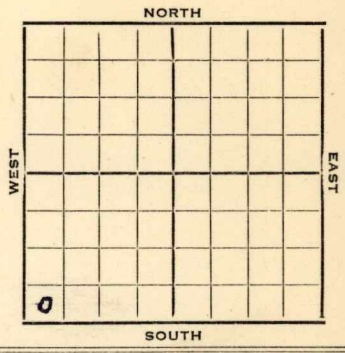

(1718 Ls

1952 Elev.(1721' REPORT

12/10 Spud 11-24-52
D&A
TD 3265'
10" @ 162
Heeb 2732, Br. lime 2855, Lans 2884, B KC 3160, Arb. 3225
DST 3233-65, opn 1 hr., rec. 700' sw 0#
TD 3265
D&A

FIRST REPORT
✓
ABANDONED

FORM 275 FOR SALE BY KANSAS BLUE PRINT CO.


County Rice State Kansas

Sec. 21 (Blk. Twp.) 18 (Sur. Rge.) 9W Map No.

Operator Pickrell Drlg.

Well No. 1 Farm Schoonover

Elev. 1721 1718 LS Location SW SW SW

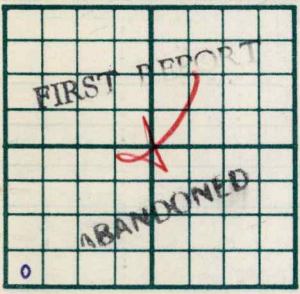

330 Ft. From S Line SW

330 Ft. From W Line Quarter

1st. Report DEC 10 1952

Completion DEC 10 1952

Remarks

Pickrell Drlg. - Contr.

Spudding Date 11-24-52

Drlg. Data D & A TD 3265

10" @ 162 Heeb. 2732 Br. lime 2855

Lans. 2884 B KC 3160 Arb. 3225

DST 3233-65 open 1 hr. Rec. 700' sw 0#

TD 3265

D & A

J. G. McGEHEE