


Section 21 Township 18 Range 11W

Well No. #1 Schlochtermeyer

Company Champlin Ref.

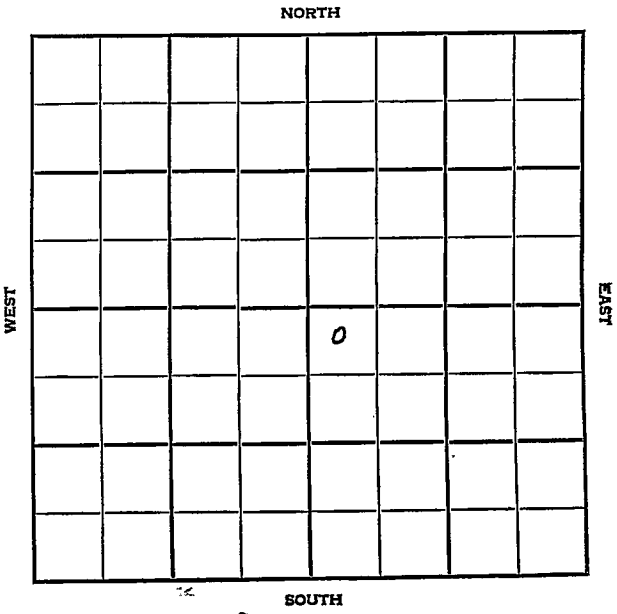

Barton KANSAS

| | | |
|------|------|-----|
| SEC. | TWP. | R. |
| 21 | 18 | 11W |

WELL NO.

1 Schlochtermeyer

FARM

COMPANY

Champlin Ref.

CONTRACTOR

Armer


Wildcat

330 Ft. from N. Line

Ft. from S. Line

Ft. from E. Line

330 Ft. from W. Line

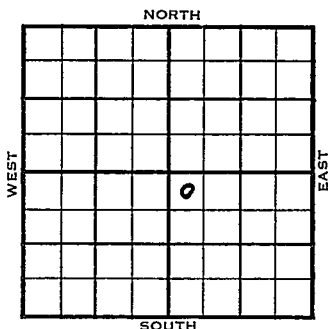

NW NW SE

| | ELEVATION | REPORT |
|-------|---|-----------|
| 1954 | 1807' | |
| 11/23 | RUR | |
| 12/8 | Spud 11-23-54 D & A TD 3400' 8" @ 247' Heeb 2946', Br. Lime 3055' Lans 3068' DST 3057'-65' opn 1 hr, rec 4' ocm, 12' drlg. mud, 0# DST 3094'-3115' opn 1 hr, rec 1236' gas 70' gc & vsom; 470# B KC 3348' Cong 3354' Arb. 3375' DST 3377'-91' opn 1 hr, rec 10' drlg mud, 120# DST 3391'-3400' opn 1 hr, rec 30' msw, 980# TD 3400' D & A Log Tops: Br. Lime 3057', Lans 3072' B KC 3348' Cong 3356' Detridal Arb. 3375', Arb. 3380' TD 3396' | ABANDONED |

County Barton State Kansas

Sec. 21 (Blk. 18 (Sur. Rge.) 11W Map No.

Operator Champlin Ref.

Well No. 1 Farm Schlochtermeyer

Elev. 1807 Location NW NW SE

| | | | | | |
|--|--|--|--|--|--|
| | | | | | |
| | | | | | |
330 Ft. From N Line SE

330 Ft. From W Line Quarter

1st. Report

Completion DEC 8 1954

Remarks Wildcat

Armer - Contr.

Spudding Date 11-23-54

Drlg. Data D & A TD 3400

8" @ 247 Heeb. 2946 Br. lime 3055

Lans. 3068 DST 3057-65 open 1 hr.

Rec. 4' ocm 12' drlg. mud 0#

DST 3094-3115 open 1 hr. Rec. 1236' gas

70' gc & vsom 470# B KC 3348

Cong. 3354 Arb. 3375 DST 3377-91 open

1 hr. Rec. 10' drlg. mud 120#

DST 3391-3400 open 1 hr. Rec. 30' msw

980# TD 3400

D & A

Log Tops:

Br. lime 3057 Lans. 3072 B KC 3348

Cong. 3356 Detridal Arb. 3375 Arb. 3380

TD 3396

FABEN OIL STRAP