KANSAS


FORM 51 SM 6-46 PETROL

Barton county

Section 21 Township 18 Range 11-W

Well No. #1, Maas

Company Cities Service Oil Company

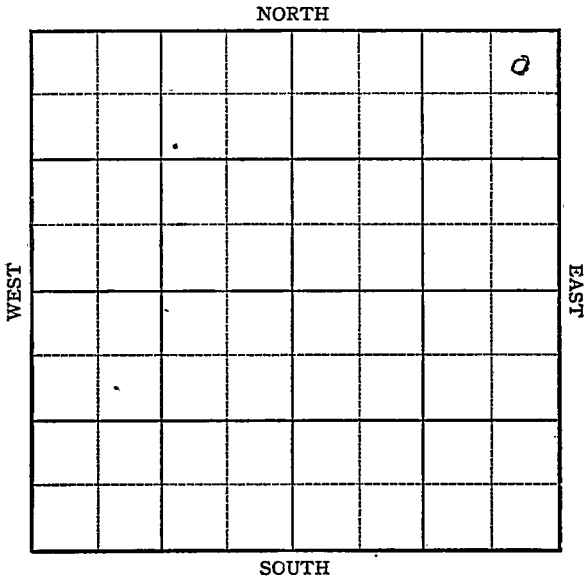

FORM 252-A
5M 6-46 PETROL

KANSAS

Barton

Sec. 21 Twp. 18 R. 11W

Well No. 1 Maas Farm

Cities Service Company

Straub Pool


330 Ft. from N. Line

Ft. from S. Line

330 Ft. from E. Line

Ft. from W. Line

NE/C

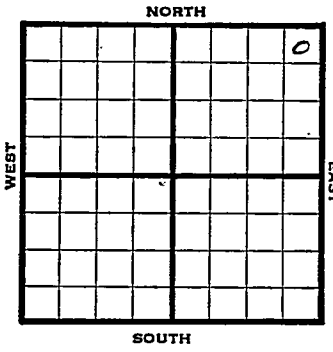

1946	REPORT Elev. 1782
11/27	Location
12/3	8" @ 247' Drlg 340'
12/10	Drlg 3385'
12/17	Lans 3053' Arb 3335' 5" @ 3336 TD 3356' 475' oil, ran liner
1947	
1/4	30' of 4½" liner @ 3356 TD3370 W PB 3283' 8 shots 3105-12 Flowed 273 oil in 4 hrs No W
1/8	" " "
1/15	Flow 137 oil in 7 3/4 hrs
1/21	" " "
1/30	" " "
2/5	" " "
2/12	" " "

OVER

2/19 Lans 3053
Arb 3335
5" @ 3336
Perf Lans
Bump 250 Pot
Grav. 40
TD 3356'

COMPLETED

Straub Pool

Form 26 200 Bks. 10-46 Petrol

Kansas

Map No. 55 Sec. 21 Twp. 18 R. 11W

Well No. 1 Maas

Cities Service Company

FIRST REPORT Contractor

NE/C


330 Ft. from N. Line

Ft. from S. Line

330 Ft. from E. Line

Ft. from W. Line

SECTION PLAT

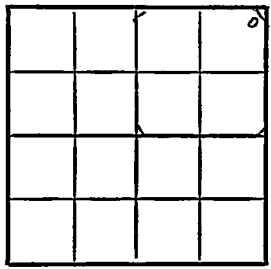

Barton County

Location X

Rig up

Drilling and Remarks:

RECORD

Cased in., ft.

Sand

Gas

Oil

Total Depth

PRODUCTION

1st 24 hrs. Nat.

1st 24 hrs. after shot

Gas Cu. Ft.

Dry Hole

Abandoned

Date

NOV 27 1946

19

S. J. LEWIS Scout

Form 26 200 Bks. 10-46 Petrol Kansas KANSAS

Straub Pool

Map No. 55 Sec. 21 Twp. 18 R. 11W

Well No. 1 Maas


Cities Service Company

COMPLETE Contractor

NE/C

E.L. 1782

SECTION PLAT

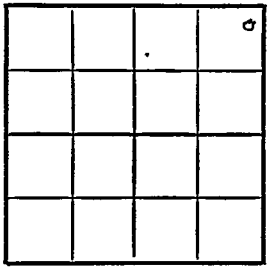

330 Ft. from N. Line

Ft. from S. Line

330 Ft. from E. Line

Ft. from W. Line

Barton County

Location

Rig up

Drilling and Remarks:

Lans 3055
OH 3335
5" @ 3336
Perf Lans.
Pump 250 BO
40 - Gr

RECORD

Cased in., ft.

Sand

Gas

Oil

Total Depth 3356

PRODUCTION

1st 24 hrs. Nat.

1st 24 hrs. after shot

Gas Cu. Ft.

Dry Hole

Abandoned

Date

FEB 19 1947 19

S. J. LEWIS Scout