
FORM 51 25M 8-50 WESTERN Barton KANSAS

Section 21 O. W. P. B. Township 18 Range 11W

Well No. #3 Maes

Company Cities Service

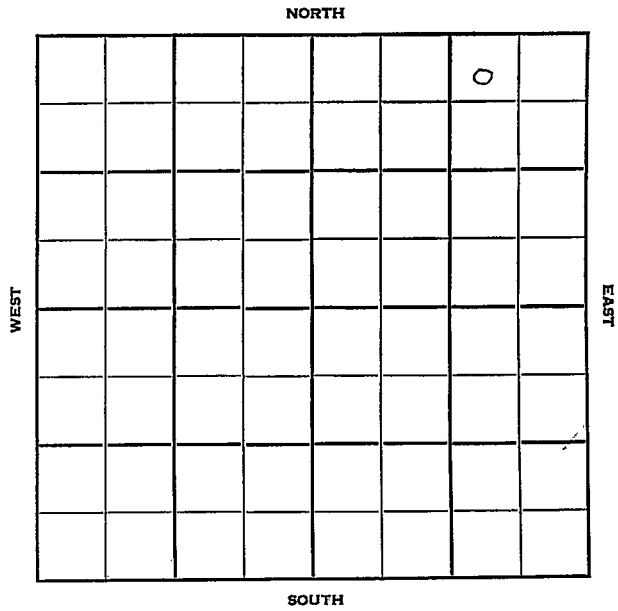

FORM 252-B
10M 10-50 PETROL

O. W. P. B. Barton KANSAS

Sec. 21 Twp. 18 R. 11W

Well No. #3 Maes Farm

Cities Service Company

Braden Drlg. Contractor

Ames Pool


330' Ft. from N. Line

Ft. from S. Line

990' Ft. from E. Line

Ft. from W. Line

NW NE NE

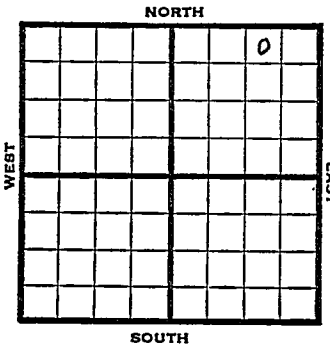

1951	REPORT Elev. 1793'
9/5	Spud 9-2-51 8" @ 307 WOC
10/3	Spud 9-2-51 Oil well TD 3349' 8" @ 307 Lans. 3046' DST 3081-90' open ½ hr. rec 40' HGCM DST 3128-44 open ½ hr. rec 60' O & GCM 240' oil DST 3147-70 open ½ hr, rec 67' water Arb. 3333-34' 5" @ 3334' TD 3349' 1000 A Comp. 161 BOPD COMPLETED O. W. P. B.
1953	
9/16	Oil Well TD 3349' Lans 3046, Arb 3331 OTD 3349 PB 3257 13/ 3126-38 24/ 3130-38 12/ 3126-30 2000 A Comp. 13 bopd 100 bw. FIRST REPORT COMPLETED

FORM 275 FOR SALE BY KANSAS BLUE PRINT CO.


County Barton State Kansas

Sec. 21 (Blk. Twp.) 18 (Sur. Rge.) 11W Map No.

Operator Cities Service

Well No. 3 Farm Maes

Elev. Location NW NE NE

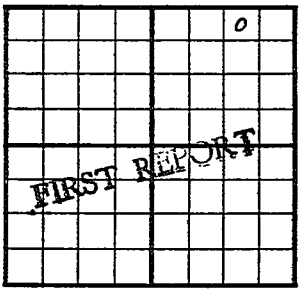

330 Ft. From N Line NE

990 Ft. From E Line Quarter

1st. Report SEP 5 1951

Completion

Remarks

Braden Drlg. - Contr.

Spudding Date .. 9-2-51

Drlg. Data Ames Pool

8" @ 307 WOC

J. E. TYRA

FORM 275 FOR SALE BY KANSAS BLUE PRINT CO.


County Barton State Kansas

Sec. 21 (Blk. Twp.) 18 (Sur. Rge.) 11W Map No.

Operator Cities Service

Well No. 3 Farm Maes

Elev. 1793 Location NW NE NE

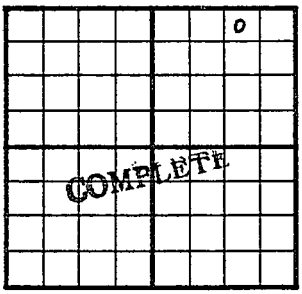

330 Ft. From N Line NE

990 Ft. From E Line Quarter

1st. Report

Completion OCT 3 1951

Remarks Ames Pool

Braden Drlg. - Contr.

Spudding Date 9-2-51

Drlg. Data Oil well TD 3349

8" @ 307 Lans. 3046 DST 3081-90

open ½ hr. Rec. 40' hgcm DST 3128-44

open ½ hr. Rec. 60' o & gcm 240' oil

DST 3147-70 open ½ hr. Rec. 67' water

Arb. 3333-34 5" @ 3334 TD 3349

1000 A Comp. 161 bopd

J. E. TYRA

FORM 275 FOR SALE BY KANSAS BLUE PRINT CO.

O.W.P.B.


County Barton State Kansas

Sec. 21 (Blk. Twp.) 18 (Sur. Rge.) 11W Map No.

Operator Cities Service Oil

Well No. 3 Farm Maes

Elev. 1793 Location NW NE NE

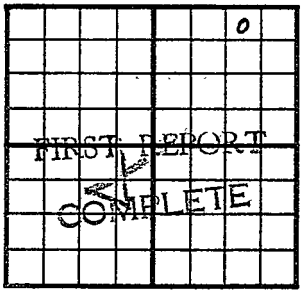

330 Ft. From N Line - NE

990 Ft. From E Line Quarter

1st. Report SEP 16 1953

Completion SEP 16 1953

Remarks OWPB

Spudding Date O.W.P.B.

Drlg. Data Oil well TD 3349

Lans. 3046 Arb. 3331 OTD 3349

PB 3257 13/ 3126-38 24/ 3130-38

12/ 3126-30 2000 A Comp. 13 bopd 100 bw

J. G. McGEHEE