


Map No. KANSAS Sec. 1 Tw. 20 R. 11W
 Well No. 1-5 M. Steckel Farm
Magnolia Pet Company

NORTH

WEST

EAST

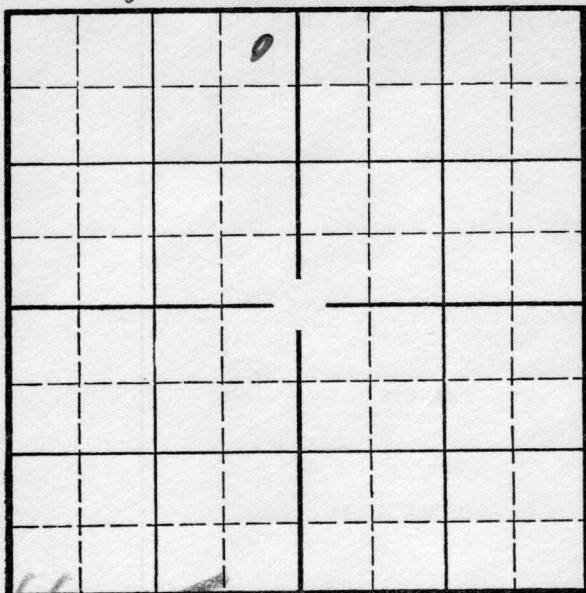

SOUTH

Location
 Drilling Remarks

Rig Up
 Drilling Remarks

RECORD

Cased _____ in. _____ ft.
 Sand _____
 Gas _____
 Oil _____
 Total Depth _____


PRODUCTION

1st 24 hrs. Nat. _____
 1st 24 hrs. after shot _____
 Gas _____ cu. ft. _____
 Dry Hole _____
 Abandoned _____

Barton

Map No. _____ Sec. 1 Twp. 20 R. 11W
Well No. 1- M. Stichel Farm _____
Magnolia Pt Company _____

330 Ft. from N. Line
____ Ft. from S. Line
330 Ft. from E. Line
____ Ft. from W. Line

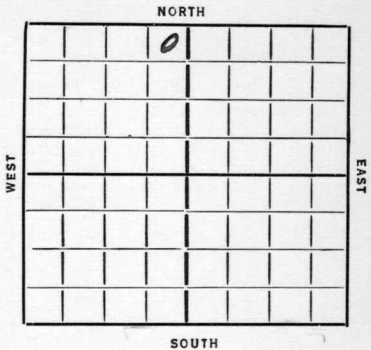

Offset

Date 1936 Elev. 1764 REPORT

1/29 Location
2/7 Rig
2/4 M & Mat
2/21 Blg 1500
2/28 " 2910
3/6 " 2985
3/13 Sil 3283
7" 3284 TD 3286
Set pumping unit
3/18 Pot 1215 Yells Oil (221)
3/18 Sil 3283
TD 3292
Pot 1215 Mat

COMPLETED

KANSAS

Map No. 46 Sec. 1 Twp. 20 R. 11WWell No. 1-M. SteckelMagnolia Pet Company

Contractor

FIRST REPORTS

SECTION PLAT

		0	

330 Ft. from N. Line

Ft. from S. Line

330 Ft. from E. Line

Ft. from W. Line

offsetLocation ☒

Rig up

Drilling and Remarks:

RECORD

Cased _____ in., _____ ft.

Sand _____

Gas _____

Oil _____

Total Depth _____

PRODUCTION

1st 24 hrs. Nat. _____

1st 24 hrs. after shot _____

Gas _____ Cu. Ft.

Dry Hole _____

Abandoned _____

Date

1-29-36 192

ORVAL MANNSCHRECK

Scout

KANSAS

Map No. 46 Sec. 1 Twp. 20 R. 11 W

Well No. 1 - Meda Steckel

Magnolia Company

Contractor

COMPLETED

SECTION PLAT

330 Ft. from N. Line

..... Ft. from S. Line

330 Ft. from E. Line

..... Ft. from W. Line

	0		

offset to our #1, Schmidt

Location.....

Rig up.....

Drilling and Remarks:

RECORD

Cased..... in., ft.

Sand Sil. 3283

Gas.....

Oil.....

Total Depth 3292

PRODUCTION

1st 24 hrs. Nat.....

1st 24 hrs. after shot.....

Gas..... Cu. Ft.

Dry Hole.....

Abandoned.....

Pat 1215 Nat.

Date

MAR 18 1936

ORVAL MANNSCHRECK

192..... Scout