


Section 1 Township 20 Range 11-W


Well Number #4 M.Steckel

Company Magnolia

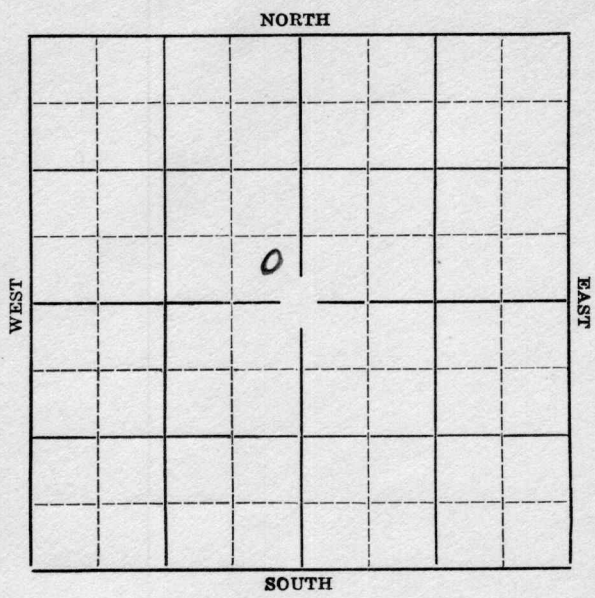

Map No. KANSAS Sec. 1 Twp. 20 R. 11-WWell No. 4-N.Steckel FarmMagnolia Company Ft. from N. Line330 Ft. from S. Line330 Ft. from E. Line Ft. from W. Line

Elev. 1764

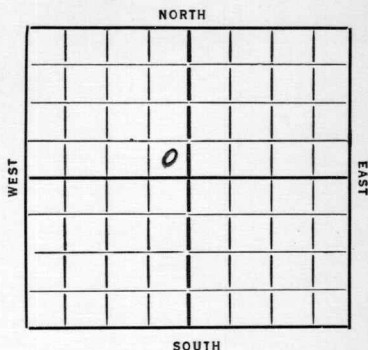Date
1936

REPORT

4/15 Spud

4/23 12½" @ 206' Drlg.

4/30 Drlg. 3280'

5/7 Sil. 3290'-7"@ 3291'. Drlg. 3304'.
100' oil in hole.5/14 T.D. 3305'. 1000 gallons. 384 bbls
Retesting.

5/20/36- Sil. 3285'.

1000 acid.

T.D. 3305'.

384 bbls potential.

COMPLETED

KANSAS

Map No. 46 Sec. 1 Twp. 20 R. 11W

Well No. 4 M Stechel

Magnolia Company

Contractor

SECTION PLAT

.....Ft. from N. Line

330 Ft. from S. Line

338 Ft. from E. Line

.....Ft. from W. Line

FIRST REPORT

Location.....

Rig up.....

Drilling and Remarks:

Spool

RECORD

Cased.....in., ...ft.

Sand.....

Gas.....

Oil.....

Total Depth.....

PRODUCTION

1st 24 hrs. Nat.....

1st 24 hrs. after shot.....

Gas.....Cu. Ft.

Dry Hole.....

Abandoned.....

Date

APR 15 1936

192

S. J. LEWIS

Scout

KANSAS

Map No. 46 Sec. 1 Twp. 20 R. 11 WWell No. 4 M. SteckelMagnolia Company

Contractor

SECTION PLAT

 Ft. from N. Line330 Ft. from S. Line330 Ft. from E. Line Ft. from W. Line

COMPLETED

Location Rig up

Drilling and Remarks:

Oil 32851000 acid384 8 1/2 ft. oil

RECORD

Cased in., ft.Sand Gas Oil Total Depth 3305

PRODUCTION

1st 24 hrs. Nat. 1st 24 hrs. after shot Gas Cu. Ft.Dry Hole Abandoned

Date

MAY 20 1936

19

S. J. LEWIS

Scout