


Map No. _____ Sec. 1 Twp. 20 R. 11-W

Well No. 5-Steckel _____ Farm _____

Magnolia _____ Company _____

NORTH

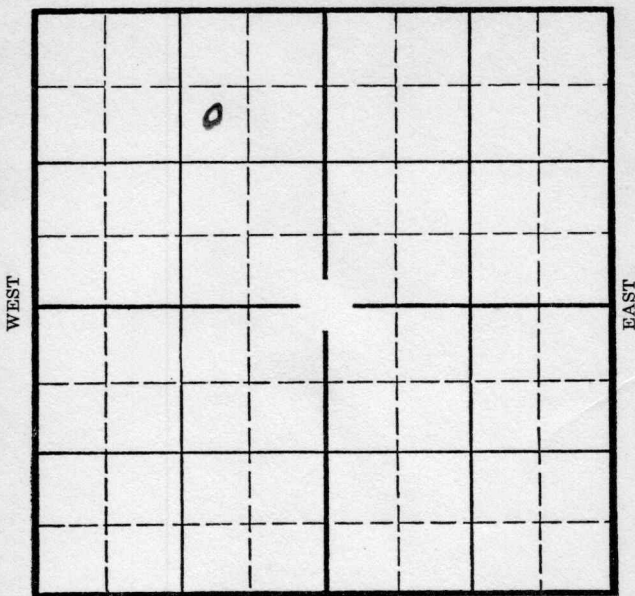

SOUTH

Location _____

Drilling Remarks _____

Rig Up _____

Drilling Remarks _____

RECORD

Cased _____ in. _____ ft.

Sand _____

Gas _____

Oil _____

Total Depth _____

PRODUCTION

1st 24 hrs. Nat. _____

1st 24 hrs. after shot _____

Gas _____ cu. ft. _____

Dry Hole _____

Abandoned _____

KANSAS

Barton

Map No. _____ Sec. 1 Twp. 20 R. 11W

Well No. #5 Steckel Farm _____

Magnolia Company _____


990' Ft. from N. Line

_____ Ft. from S. Line

990' Ft. from E. Line

_____ Ft. from W. Line

Elev. 1763

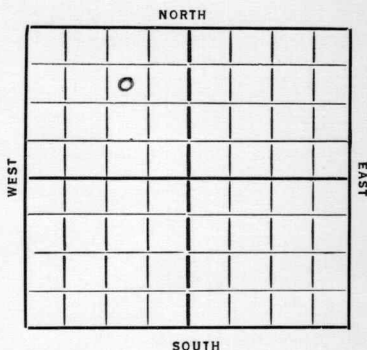

Date
1936

REPORT

4/29 Location

5/7 12" @ 200'.

5/14 Drlg. 2826'.

5/21 Sil. 3282' set 7" T.D. 3285'.

5/27/36-Sil. 3282'.

T.D. 3298'

1103 bbls natural.

COMPLETED

KANSAS

Map No. 46 Sec. 1 Twp. 20 R. 11N

Well No. 5 Steckel

Magnolia Company

Contractor

SECTION PLAT

	0		

990 Ft. from N. Line

..... Ft. from S. Line

990 Ft. from E. Line

..... Ft. from W. Line

FIRST REPORT

Location ✓

Rig up

Drilling and Remarks:

RECORD

Cased.....in.,ft.

Sand.....

Gas.....

Oil.....

Total Depth.....

PRODUCTION

1st 24 hrs. Nat.....

1st 24 hrs. after shot.....

Gas.....Cu. Ft.

Dry Hole.....

Abandoned.....

Date

APR 29 1936

.....192..... S. J. LEWIS Scout

Map No. 42 Sec. 1 Twp. 20 R. 11WWell No. 5 M SteckelMagnolia Company

Contractor

SECTION PLAT

	o		

990 Ft. from N. Line

_____ Ft. from S. Line

990 Ft. from E. Line

_____ Ft. from W. Line

COMPLETED

Location _____

Rig up _____

Drilling and Remarks:

Oil 3282.1103 28 1/2 Vaid

RECORD

Cased _____ in., _____ ft.

Sand _____

Gas _____

Oil _____

Total Depth 3298.

PRODUCTION

1st 24 hrs. Nat. _____

1st 24 hrs. after shot _____

Gas _____ Cu. Ft.

Dry Hole _____

Abandoned _____

Date

MAY 27 1936 19

S. J. LEWIS Scout