


KANSAS

FORM 51 IOM 12-46 PETROL

Section 22 Township 18 Range 11-W Barton

Well No. #5 Oberle

Company Sinclair-Prairie

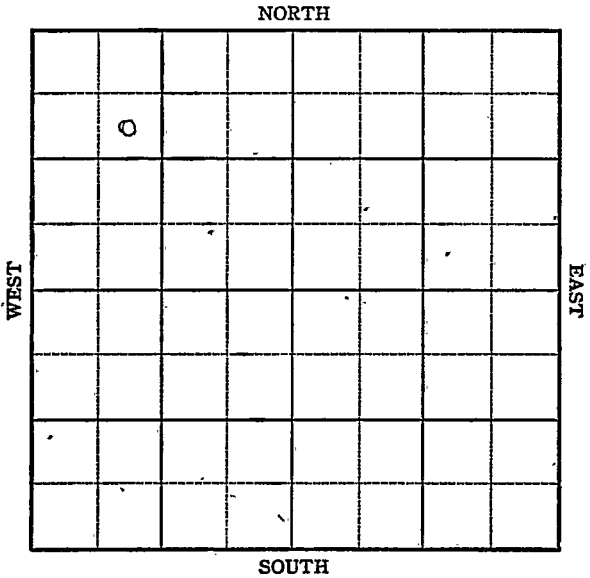

KANSAS

B

Barton

Sec. 22 Twp. 18 R. 11-W ✓

Well No. #5 Oberle Farm

Sinclair-Prairie Company


Straub Pool

990 Ft. from N. Line

Ft. from S. Line

Ft. from E. Line

990 Ft. from W. Line

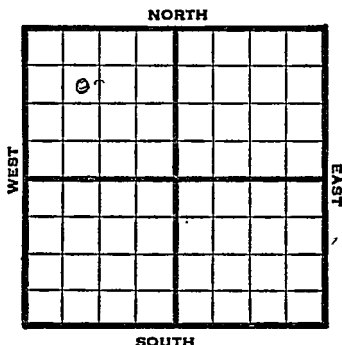

SE NW NW

REPORT

1947 1778

2/19 Location

2/26 10" @ 607'
Drlg 1690'3/4 Lans 3035
Arb 3306
TD 3328'3/11 Arb 3303 corrected
7" @ 3303
TD 3325'
Swb 10 bbls oil PH 10 hrs3/19 Arb 3303
7" @ 3303
Pump 100 Pot
Grav. 41
TD 3325'

COMPLETED

Map No. 55 Sec. 22 Twp. 18 R. 11W

Well No. 5 Oberle

Sinclair-Prairie

Company

FIRST REPORT

Contractor

SE NW NW


SECTION PLAT

990 Ft. from N. Line

 Ft. from S. Line

 Ft. from E. Line

990 Ft. from W. Line

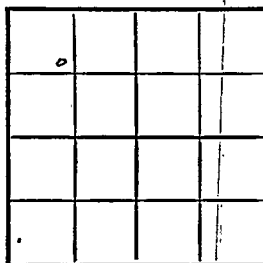

Barton County

Location K

Rig up

Drilling and Remarks:

RECORD

Cased in, ft.

Sand

Gas

Oil

Total Depth

PRODUCTION

1st 24 hrs. Nat.

1st 24 hrs. after shot

Gas Cu. Ft.

Dry Hole

Abandoned

Date

FEB 1 9 1947 19

S. J. LEWIS

Scout


KANSAS Straub Pool
KansasMap No. 55 Sec. 22 Twp. 18 R. 11WWell No. 5 OberleSinclair-Prairie

Company

COMPLETE

Contractor

SE NW NW

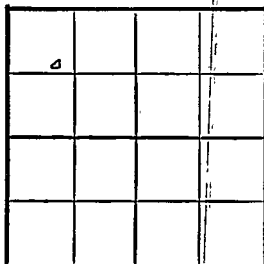E 11778
SECTION PLAT990 Ft. from N. Line Ft. from S. Line Ft. from E. Line990 Ft. from W. LineBarton CountyLocation Rig up

Drilling and Remarks:


RECORD

Cased in., ft.Sand Gas Oil Total Depth 3325

PRODUCTION

1st 24 hrs. Nat. 1st 24 hrs. after shot Gas Cu. Ft.Dry Hole Abandoned

Date

MAR 19 1947S. J. LEWIS

Scout