
KANSAS
FORMERLY SM PETROL

Barton

Section 22 Township 18 Range 11W

Well No. #1 B. Oberle

Company Sinclair-Prairie

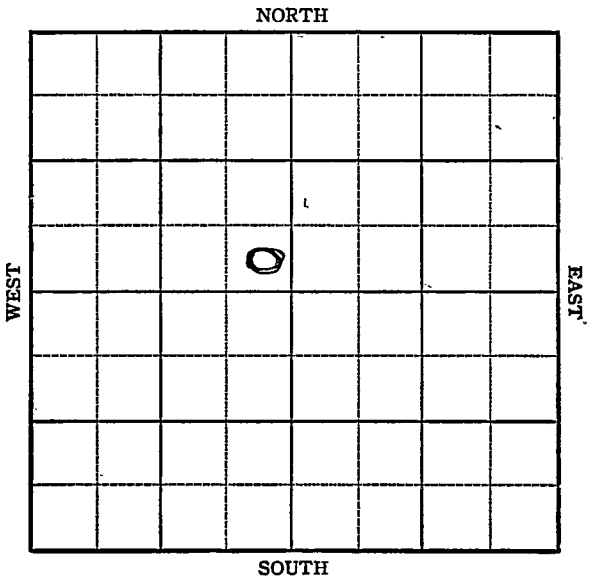

FORM 252-A
5M 3-44 PETRO

KANSAS

Barton

Sec. 22 Twp. 18 R. 11W

Well No. #1 B. Oberle Farm

Sinclair-Prairie Company


Ames Pool

_____ Ft. from N. Line

330 Ft. from S. Line

330 Ft. from E. Line

_____ Ft. from W. Line

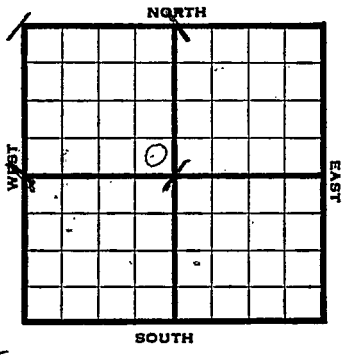

Elev. 1772

1944	REPORT
4/5	Derrick
4/12	Drlg. 585
4/19	Drlg. 1980 8" @ 580
4/26	Drlg. 2980&
5/3	LLans 3017 SO 3017-20, 3064-70, 3112-26 Cong 3293 Arb 3315-20 TD No shows 5" @ 3315 Rust.
5/10	" "
5/17	" "
5/24	Drlg. 3344
5/31	TD 3349 Plug 3102-45 shot to 3039-42 1000 acid Swb 95 oil in 3½ hrs.

OVER

1944

6/7 5" @ 3315
Lans 3017
Arb. 3315
TD 3349
PB 3102
45 shots to 3039-47
1000 acid
Pump 463 Pot.
Grav. 41.7

COMPLETED

Form 26 200 Bks 5-42 Petrol Barton

Map No. 55 Sec. 22 Twp. 18 R. 11W


Well No. 1 B. Oberle

Sinclair-Prairie Company

FIRST REPORT Contractor

SE NW

SECTION PLAT

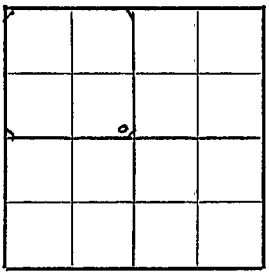

____ Ft. from N. Line

330 Ft. from S. Line

330 Ft. from E. Line

____ Ft. from W. Line

Ames Pool

Location

Rig up

Drilling and Remarks:

Derrick

RECORD

Cased ____ in., ____ ft.

Sand

Gas

Oil

Total Depth

PRODUCTION

1st 24 hrs. Nat.

1st 24 hrs. after shot

Gas ____ Cu. Ft.

Dry Hole

Abandoned

Date

APR 5 1944 19 S. J. LEWIS Scout

FORM 26 2-0 BKS. 2-44 PETROL

KANSAS

Pool Name Ames

Map No. 55 Sec. 22 Twp. 18 R. 11W


Well No. 1 B. Oberle

Sinclair-Prairie Company

COMPLETED Contractor

SE NW

SECTION PLAT

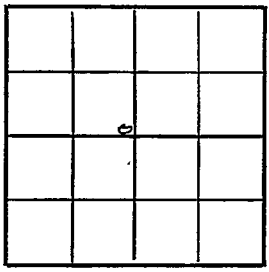

____ Ft. from N. Line

330 Ft. from S. Line

330 Ft. from E. Line

____ Ft. from W. Line

Barton County

Location

Rig up

Drilling and Remarks:

Lans 3017
Cir 3315
5" @ 3315
PB 3102
45 sks to 3039-47
1000 acid
Pump. 463 BO
41 3/4 Gr

Date

JUN 7 1944 19

RECORD

Cased ____ in., ____ ft.

Sand

Gas

Oil

Total Depth 3349

PRODUCTION

1st 24 hrs. Nat.

1st 24 hrs. after shot

Gas ____ Cu. Ft.

Dry Hole

Abandoned

S. J. LEWIS Scout