

Section 23 Township 18 Range 11W

Well No. #1 Stout

Company Aladdin Petr.

NORTH

WEST

EAST

SOUTH

Barton

KANSAS

Sec. 23 Twp. 18 R. 11W

Well No. #1 Stout Farm

Aladdin Petroleum Company

Crowe Drlg. - Contr. Contractor

Wildcat


 Ft. from N. Line

330' Ft. from S. Line

 Ft. from E. Line

330' Ft. from W. Line

SW SW NE

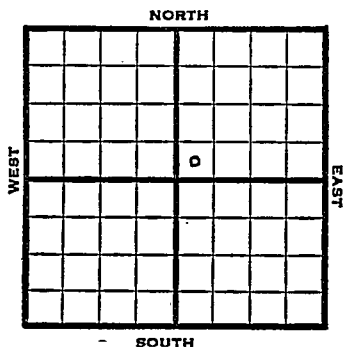

1950

Elev. 1769' REPORT

10/25

RUR

11/15

Spud 10-31-50

D&A TD 3361'

8" @ 237'

Anhy 555-75 Br Lime 3001'

KC 3020' Cong. 3301'

DST 3304-17 opn 1 hr

Rec. 2040' sw


Arb. 3331'

TD 3361' D&A

ABANDONED

J. E. TYRA

County Barton State Kansas
 Sec. 23 (Blk. 18) (Sur. 11W) Map No. 11W
 Operator Aladdin Petroleum
 Well No. 1 Farm Stout
 Elev. 1769 Location SW SW NE

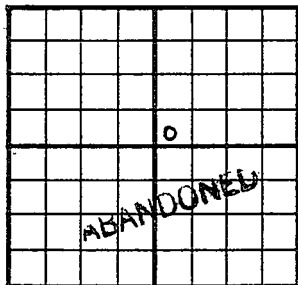

330Ft. From S Line NE

330Ft. From W Line Quarter

1st. Report

Completion NOV 15 1950

Remarks Wildcat

Crowe Drlg. - Contr.

Spudding Date 10-31-50

Drlg. Data D & A TD 3361

8" @ 237 Anhy 555-75 Br. lime 3001

KC 3020 Cong. 3301 DST 3304-17

open 1 hr. Rec. 2040' sw Arb. 3331

TD 3361 D & A

J. E. TYRA