

KANSAS


Barton

FORM 51 5M 1-42 PETROL

Section 22 Township 18 Range 11-W

Well No. #1 Ames

Company Edourd Jonas etal

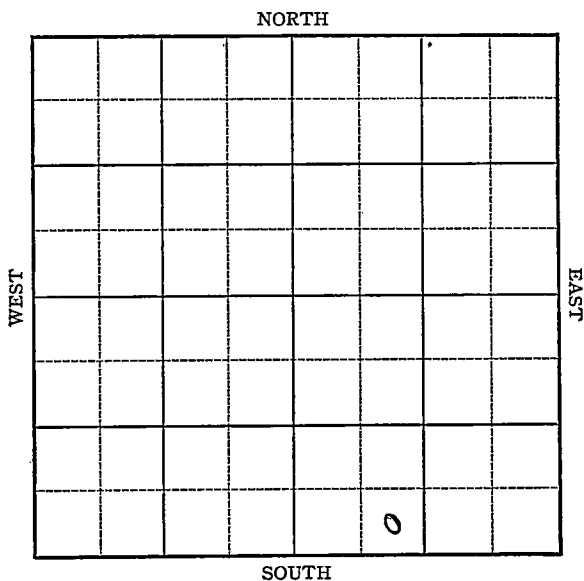

KANSAS

Barton

Sec. 22 Twp. 18 R. 11-W

Well No. #1 Ames Farm

Edourd Jones etal Company

Wildcat


 Ft. from N. Line

330 Ft. from S. Line

 Ft. from E. Line

990 Ft. from W. Line

Elev. 1780

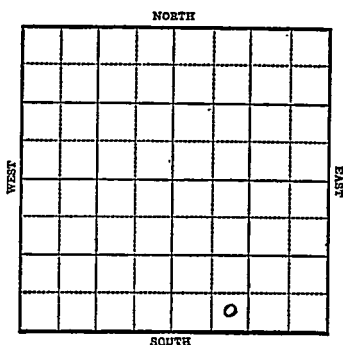

1943

R E P O R T

5/26

Location.

6/2

8" @ 218

Drlg. 1700'

6/9

Topeka 2630

Drlg. 2748

6/16

Lans 3023

Arb 3308

5" @ 3311

T.D. 3320 Sat. Rust

6/23

T.D. 3320'

No show

SD for orders.

6/30

T.D. 3329-1500 acid

P.B. 3145

32 shots 3043-49-1800' oil 8 hrs

7/7

2000 acid flow 110 oil in 4 hrs.

7/15

" " " " "

7/21

" " "

7/28

" " "

8/4

" " "

OVER

1943

8/11

Lans 3023

Arb 3308

5" @ 3311

PB 3145

Perf Lans

2000 acid pump 287 Pot.

T.D. 3329

Gravity 46

COMPLETED

Barton

KANSAS
 Map No. 53 Sec. 22 Twp. 18 R. 11W

Well No. 1 Ames
Edourd Jonas etal. Company

FIRST REPORT Contractor

SE SW SE

_____ Ft. from N. Line

330 Ft. from S. Line

_____ Ft. from E. Line

990 Ft. from W. Line

SECTION PLAT

0

WILDCAT

Location XXX

Rig up _____

Drilling and Remarks:

RECORD

Cased _____ in., _____ ft.

Sand _____

Gas _____

Oil _____

Total Depth _____

• PRODUCTION •

1st 24 hrs. Nat. _____

1st 24 hrs. after shot _____

Gas _____ Cu. Ft.

Dry Hole _____

Abandoned _____

Date

MAY 26 1943

19

S. J. LEWIS Scout

Barton

KANSAS
 Map No. 5 Sec. 22 Twp. 18 R. 11W

Well No. 1 Ames

Edourd Jonas etal. Company

COMPLETED Contractor

SE SW SE

SECTION PLAT

 Ft. from N. Line330 Ft. from S. Line Ft. from E. Line990' Ft. from W. Line

		1	0

AMES POOL

Location Rig up

Drilling and Remarks:

Line 3023
22 x 3308
5" @ 3311
PS 3145
Perf done.
2000 acid
Pump 287 Ps
46 0 Rev

RECORD

Cased in., ft.Sand Gas Oil Total Depth 3329

PRODUCTION

1st 24 hrs. Nat. 1st 24 hrs. after shot Gas Cu. Ft.Dry Hole Abandoned

Date

AUG 11 1943

19

S. J. LEWIS Scout