


Form 51—5M—3-35—Mid-West

Map No. KANSAS Sec. 1 Twp. 20 R. 11-W
Well No. #6 F. Steckel Farm _____
Magnolia Company _____

NORTH

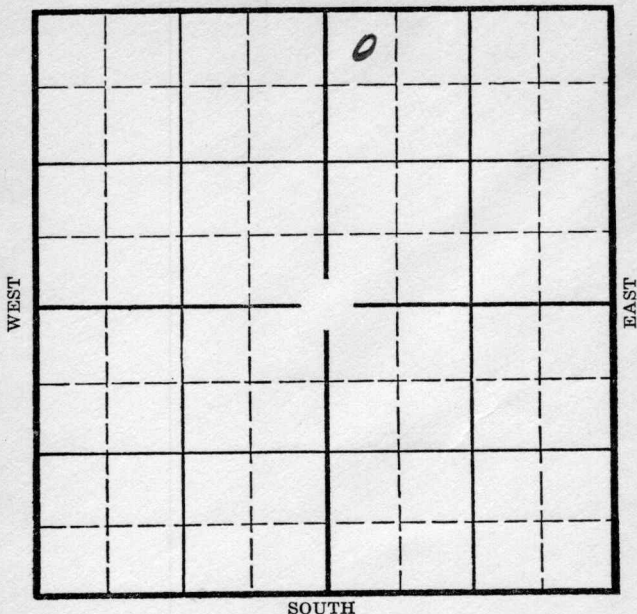

Location _____
Drilling Remarks _____

Rig Up _____
Drilling Remarks _____

RECORD

Cased _____ in. _____ ft.
 Sand _____
 Gas _____
 Oil _____
 Total Depth _____

PRODUCTION

1st 24 hrs. Nat. _____
1st 24 hrs. after shot _____
Gas _____ cu. ft. _____
Dry Hole _____
Abandoned _____

Barton

Map No. Sec. 1 Twp. 20 R. 11W
Well No. 6- F. Stechel Farm
Magnolia Company


330 Ft. from N. Line

_____ Ft. from S. Line

_____ Ft. from E. Line

330 Ft. from W. Line

Elev. 1763

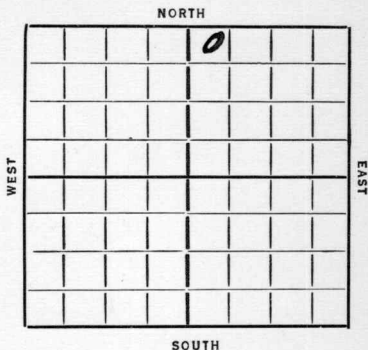

REPORT

~~1/28~~
2/17 Location
2/21
2/28 Skidding in rig
3/6 Rgn
3/13 Dlg 200 12" 198
3/20 Drlg 1500
3/27 Drlg. 3080'
4/2 T. Sil. 3267' 7"-3267' T.D. 3270'
RUST.
4/10 Sil. 3271' T.D. 3276'- 3000' oil
6 hours.
4/16 --
4/15 Sil 3271
TD 3286
Potential 1245 Natural

COMPLETED

Barton
Map No. 4 Sec. 1 Twp. 20 R. 11WWell No. 6 - F. SteckelMagnolia Company

Contractor

SECTION PLAT

330 Ft. from N. Line

Ft. from S. Line

Ft. from E. Line

330 Ft. from W. Line

		0	

Location ☒

Rig up

Drilling and Remarks:

RECORD

Cased _____ in., _____ ft.

Sand _____

Gas _____

Oil _____

Total Depth _____

PRODUCTION

1st 24 hrs. Nat. _____

1st 24 hrs. after shot _____

Gas _____ Cu. Ft.

Dry Hole _____

Abandoned _____

Date

ORVAL MANNSCHRECK

2-12-36 192 Scout

KANSAS

Map No. 46 Sec. 1 Twp. 20 R. 11 WWell No. 6-17 SteckerMagnolia Company

Contractor

SECTION PLAT


330 Ft. from N. Line

Ft. from S. Line

Ft. from E. Line

330 Ft. from W. Line

COMPLETED

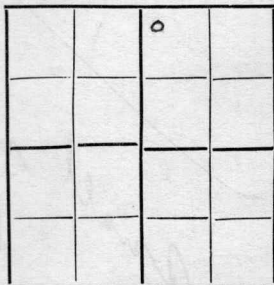

Location

Rig up

Drilling and Remarks:

Sil 3271Potential1245 Nat.

RECORD

Cased in., ft.Sand Gas Oil Total Depth 3286

PRODUCTION

1st 24 hrs. Nat. 1st 24 hrs. after shot Gas Cu. Ft.Dry Hole Abandoned

Date

APR 15 1936

192

S. J. LEWIS

Scout