


Map No. 6 Sec 1 Twp 20 R. 11W
Well No. 6 L. A. Stichel Farm
Gypsy Company

NORTH

WEST

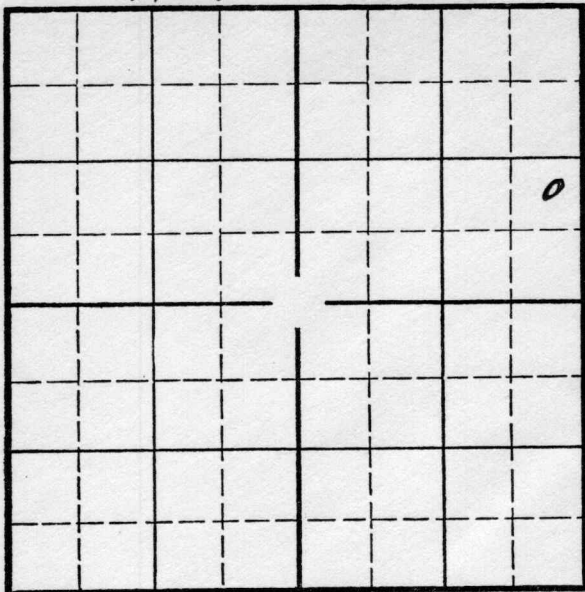

EAST

SOUTH

Location _____
Drilling Remarks _____

Rig Up _____
Drilling Remarks _____

RECORD

Cased _____ in. _____ ft.
Sand _____
Gas _____
Oil _____
Total Depth _____

PRODUCTION

1st 24 hrs. Nat. _____
1st 24 hrs. after shot _____
Gas _____ cu. ft. _____
Dry Hole _____
Abandoned _____

Easton

Map No. Sec. 1 Twp. 20 R. 11W
Well No. 6 L. A. Stechel Farm
Gypsy Company


 Ft. from N. Line

990 Ft. from S. Line

330 Ft. from E. Line

 Ft. from W. Line

Elev. 1761

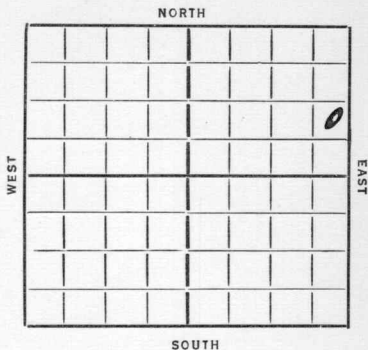

REPORT

~~1/15~~
1/15 B. Rotary Rig
1/24 10" 156 WOC
1/31 Delg 3239 3252
2/7 T Del 3254 TD 3255
Run 6" 3252
2/14 T Del 3255 (Corr)
9" 3256 TD Rust
2/21 TD 3270
2/26 pumped 6 3/4 Oil 9 hrs.
Del 3252 Corrected
TD 3270
Pot 1729 Oil Natural

COMPLETED

KANSAS

Map No. 46 Sec. 1 Twp. 20 R. 11W

Well No. 6 - L. A. Steckel

Gypsy Company

Contractor

FIRST REPORTS

SECTION PLAT

			0

.....Ft. from N. Line

990 Ft. from S. Line

330 Ft. from E. Line

.....Ft. from W. Line

Location.....

Rig up.....

Drilling and Remarks:

B. Rotary Rig

RECORD

Cased.....in.,ft.

Sand.....

Gas.....

Oil.....

Total Depth.....

PRODUCTION

1st 24 hrs. Nat.....

1st 24 hrs. after shot.....

Gas.....Cu. Ft.

Dry Hole.....

Abandoned.....

Date

ORVAL MANNSCHRECK

1-15-36 192.....Scout

Map No. *46* Sec. *1* Twp. *20* R. *11W*

Well No. *6-Steckel*

Gypsy Company

Contractor

SECTION PLAT

COMPLETED

.....Ft. from N. Line

990 Ft. from S. Line

.....*330* Ft. from E. Line

.....Ft. from W. Line

Location.....

Rig up.....

Drilling and Remarks:

Pat 1729 oil
natural

RECORD

Cased.....in.,ft.

Sand *Sil 3252 (corrected)*

Gas.....

Oil.....

Total Depth *3270*

PRODUCTION

1st 24 hrs. Nat.....

1st 24 hrs. after shot.....

Gas.....Cu. Ft.

Dry Hole.....

Abandoned.....

Date

ORVAL MANNSCHRECK

FEB 26 1936

192.....Scout