
FORM 51 25M 3-49 PETROL Barton KANSAS

Section 22 Township 18 Range 11W

Well No. #3 Oberle

Company Woodriver Oil

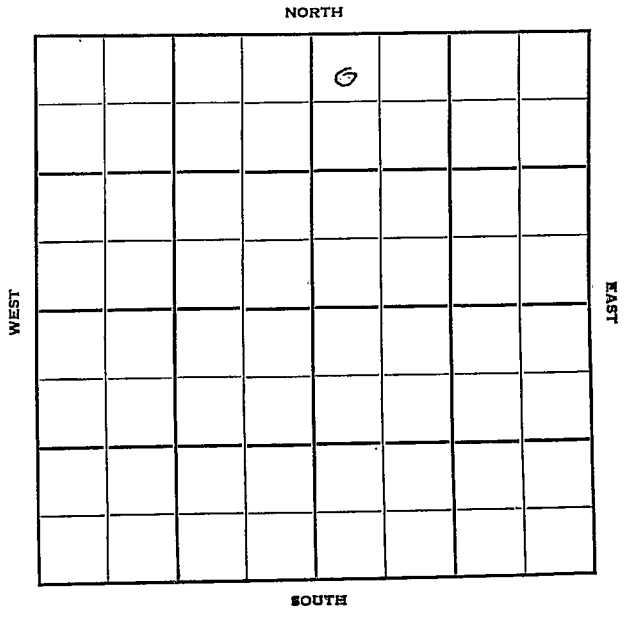

FORM 252-B
10M 8-51 TPCO.

Barton KANSAS

Sec. 22 Twp. 18 R. 11 W

Well No. # 3 Oberle Farm

Woodriver Oil Company

Ferrell Drlg. Contractor

Ames Pool


330 Ft. from N. Line

Ft. from S. Line

Ft. from E. Line

330 Ft. from W. Line

NW NW NE

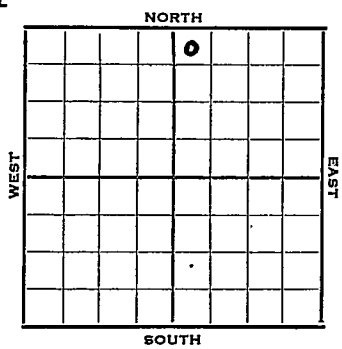

1952	Elev. 1777' REPORT
10/15	Spud 10-12-52 8" @ 248 WOC
10/22	Topeka 2642' Heeb 2904' Douglas 2936' Br. li 3018' Lans. 3035' DST 3036-70'
10/29	Spud 10-12-52 D&A TD 3359' 8" @ 248' Top. 2642', Heeb. 2904', Doug. 2936', Br. Lime 3018', Lans 3035' DST 3036-70, opn 1 hr., rec. 23' OCM 0# DST 3070-3115, opn 1 hr., rec. 60' OCM DST 3250-74, opn 1 hr., rec. 30' gas 30' OCM Arb. 3336 TD 3359' D&A ABANDONED

FORM 275 FOR SALE BY KANSAS BLUE PRINT CO.


County Barton State Kansas

Sec. 22 (Blk. Twp.) 18 (Sur. Rge.) 11W Map No.

Operator Woodriver Oil

Well No. 3 Farm Oberle

Elev. Location NWNW NE

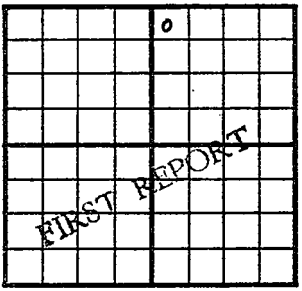

330 Ft. From N Line NE

330 Ft. From W Line Quarter

1st. Report OCT 15 1952

Completion

Remarks Ferrell Drlg. - Contr.

Spudding Date 10-12-52

Drlg. Data Ames Pool

8"@248 WOC

J. G. McGEHEE

FORM 275 FOR SALE BY KANSAS BLUE PRINT CO.


County Barton State Kansas

Sec. 22 (Blk. Twp.) 18 (Sur. Rge.) 11W Map No.

Operator Woodriver Oil

Well No. 3 Farm Oberle

Elev. 1777 Location NW NW NE

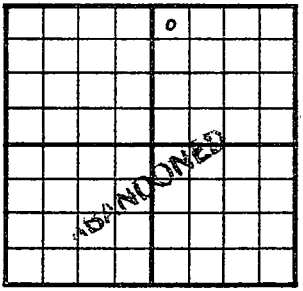

330 Ft. From N Line NE

330 Ft. From W Line Quarter

1st. Report

Completion OCT 29 1952

Remarks Ames Pool

Ferrell Drlg. - Contr.

Spudding Date 10-12-52

Drlg. Data D & A TD 3359

8" @ 248 Top. 2642 Heeb. 2904

Doug. 2936 Br. lime 3018 Lans. 3035

DST 3036-70 open 1 hr. Rec. 23' ocm

0# DST 3070-3115 open 1 hr. Rec. 60'

ocm DST 3250-74 open 1 hr. Rec. 30'

gas 30' ocm Arb. 3336 TD 3359

D & A

J. G. McGEHEE