FORM 51 10M 8-47

KANSAS


Barton

Section 22 Township 18 Range 11W

Well No. #7 Oberle

Company Sinclair-Prairie

Ames Pool

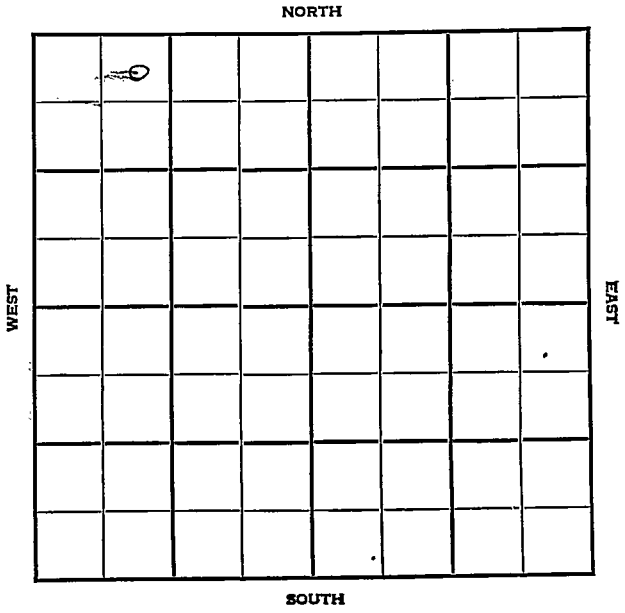

FORM 252-A
5M 12-45 PETROL

Barton KANSAS

Sec. 22 Twp. 18 R. 11W

Well No. #7 Oberle Farm

Sinclair-Prairie Company

Ames


330 Ft. from N. Line

Ft. from S. Line

Ft. from E. Line

990 Ft. from W. Line

NE NW NW

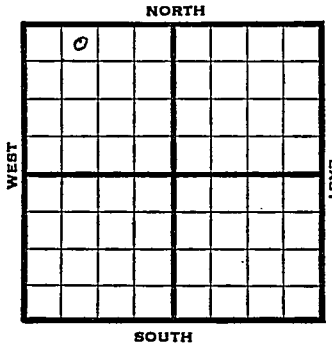

1948	Elev. 1785' REPORT
4/7	Location
4/14	"
4/21	"
4/28	RUR
5/5	10" @ 1034' WOC
5/12	Drlg. 3240'
5/19	Lansing 3031' Arbuckle 3325' TD 3335' 7" @ 3330' Plug 3090' 36 shots 3063-70 - 5000 acid swb 12 bbls oil & 2 W PH
5/26	Lans. 3031' Arbuckle 3325' 7" @ 3330' Perf Lans 500 Acid Pump 75 oil & 15W pot. Gr. 38° TD 3335'

COMPLETED

Form 26—200 Bks.—1-48—Palace

Ames Pool

Kansas

Map No. _____ Sec. 22 Twp. 18 R. 11W


Well No. 7 Oberle

Sinclair-Prairie Company

FIRST REPORT Contractor

NE NW NW

SECTION PLAT

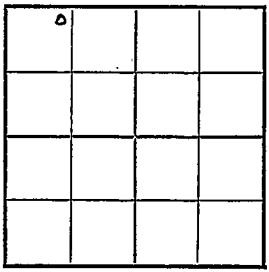

330 Ft. from N. Line

_____ Ft. from S. Line

_____ Ft. from E. Line

990 Ft. from W. Line

Barton County

Location x

Rig up

Drilling and Remarks:

RECORD

Cased _____ in., _____ ft.

Sand

Gas

Oil

Total Depth

PRODUCTION

1st 24 hrs. Nat.

1st 24 hrs. after shot

Gas _____ Cu. Ft.

Dry Hole

Abandoned

Date

APR 7 1948 19

S. J. LEWIS Scout

Form 26—200 Bks.—1-48—Palace

Ames Pool

Kansas

Map No. 55 Sec. 22 Twp. 18 R. 11W

Well No. 7 Oberle


Sinclair-Prairie Company

COMPLETE Contractor

NE NW NW

El. 1783

SECTION PLAT

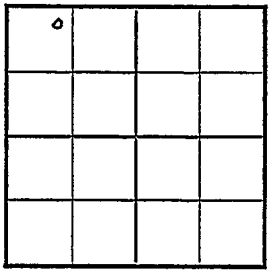

330 Ft. from N. Line

Ft. from S. Line

Ft. from E. Line

990 Ft. from W. Line

Barton County

Location

Rig up

Drilling and Remarks:

Lans 3081

CR 3325

D 3330

Prod Lans.

Pumping oil

Pump 75 oil + 15W

RECORD

Cased in., ft.

Sand

Gas

Oil

Total Depth 3335

PRODUCTION

1st 24 hrs. Nat.

1st 24 hrs. after shot

Gas Cu. Ft.

Dry Hole

Abandoned

Date

MAY 26 1948 19

S. J. LEWIS Scout