

KANSAS


Barton

Section 22 Township 18 Range 11WWell No. 8 OberleCompany Sinclair-Prairie

Ames Pool

NORTH

WEST

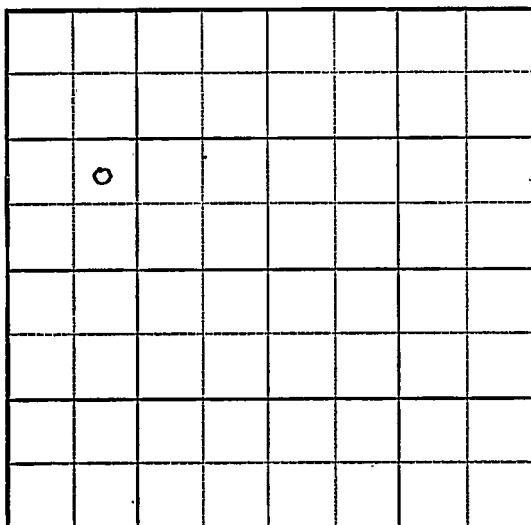

EAST

SOUTH

KANSAS

Barton

Sec. 22 Twp. 18 R. 11-W

Well No. #8 Oberle Farm

Sinclair-Prairie

Company

Ames Pool


 Ft. from N. Line

990 Ft. from S. Line

 Ft. from E. Line

990 Ft. from W. Line

NE SW NW

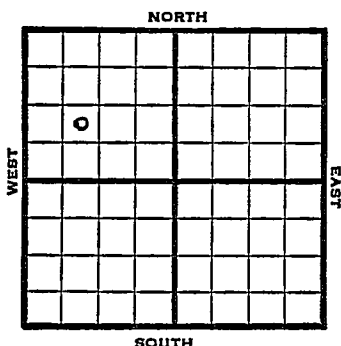

1948 Elev. 1792' REPORT

10/6 Drlg 585'

10/13 10" @ 592'
rlg 2710'

10/19 Lansing 3045'

BKG 3318'

Arb. 3367'

TD 3381'

10/26 5" @ 3373

26 shots 3070-74' 2000 acid

Swb 56 oil then went to wtr.

11/3 Lans 3045'

Arb. 3367'

5" @ 3373'

Perf Lans

3000 acid

Pump 45 oil Pot.

Gr. 370

TD 3381'

COMPLETED

Map No. _____ Sec. 22 Twp. 18 R. 11WWell No. 8 Oberle_____
Sinclair-Prairie Company**FIRST REPORT** Contractor _____

NE SW NW

SECTION PLAT

o			

Ft. from N. Line990 Ft. from S. Line_____
Ft. from E. Line990 Ft. from W. LineBarton County

Location _____

Rig up _____

Drilling and Remarks:

dr lg. 585

RECORD

Cased _____ in., _____ ft.

Sand _____

Gas _____

Oil _____

Total Depth _____

PRODUCTION

1st 24 hrs. Nat. _____

1st 24 hrs. after shot _____

Gas _____ Cu. Ft.

Dry Hole _____

Abandoned _____

Date

OCT 6 1948 19 S. J. LEWIS Scout

Kansas

Map No. 55 Sec. 22 Twp. 18 R. 11WWell No. 8 OberleSinclair-Prairie

Company

COMPLETE

Contractor

NE SW NW

E11792

SECTION PLAT

a			

 Ft. from N. Line990 Ft. from S. Line Ft. from E. Line990 Ft. from W. Line

Barton County

RECORD

Location Cased in., ft.Rig up Sand

Drilling and Remarks:

Gas Lane 3045Oil Cr 83367Total Depth 83875" 83373Perf Lane3000 andPump 45 oil Prod

PRODUCTION

1st 24 hrs. Nat. 1st 24 hrs. after shot Gas Cu. Ft.Dry Hole Abandoned

Date

87 2/94

NOV 3 1948 19

S. J. LEWIS

Scout