

SEC.	TWP.	R.
24	18	11W


WELL NO. #3 Feist. FARM

COMPANY Skelly Oil

CONTRACTOR

Roessler Pool

990 Ft. from N. Line
 _____ Ft. from S. Line
 _____ Ft. from E. Line
 990 Ft. from W. Line

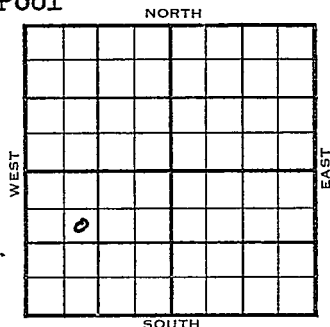

SE NW SW

1955	ELEVATION	REPORT
------	-----------	--------

4/27 Spud 4-22555-
 Anhy 553'
 8" @ 550'

