



KANSAS

Barton

Sec. 1 Twp. 20 R. 11-W

Well No. #10 Meda Steckel Farm \_\_\_\_\_  
Magnolia Company \_\_\_\_\_


\_\_\_\_\_ Ft. from N. Line

990 Ft. from S. Line

\_\_\_\_\_ Ft. from E. Line

330 Ft. from W. Line

Ele v. 1766

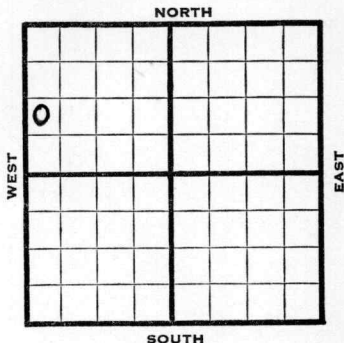

1938	REPORT
5/18	13" at 195'.
	WOC.
5/27	Drilg. 2610'.
6/3	Arb. 3277-81' T.D. S. O.
	7" @ 3277'. RUST.
6/10	T.D. 3289'. Swab 99 oil in 9
	hours. 1000 acid.
	Pump 11 oil per hour.
6/15	7" @ 3277'.
	Arb. 3277'.
	T.D. 3289'.
	1000 acid.
	Potential 803 bbls.
	No water.
	COMPLETED

Map No. 46 Sec. 1 Twp. 20 R. 11W

Well No. 10 Meda Steckel

Magnolia Company

Contractor

FIRST REPORT

NW SW NW

     Ft. from N. Line

990 Ft. from S. Line

     Ft. from E. Line

330 Ft. from W. Line

SECTION PLAT

0			

Location     

Rig up     

Drilling and Remarks:

**13" - 195**

**WOC**

RECORD

Cased      in.,      ft.

Sand     

Gas     

Oil     

Total Depth     

PRODUCTION

1st 24 hrs. Nat.     

1st 24 hrs. after shot     

Gas      Cu. Ft.

Dry Hole     

Abandoned     

Date

**MAY 18 1938** 19

**H. D. Hatfield** Scout

Map No. 46 Sec. 1 Twp. 20 R. 11W

Well No. 10 Meda Steckel

Magnolia

Company

Contractor

COMPLETED

SECTION PLAT

NW SW NW

Ft. from N. Line

990 Ft. from S. Line

Ft. from E. Line

330 Ft. from W. Line

0			

Location \_\_\_\_\_

Rig up \_\_\_\_\_

Drilling and Remarks:

*1000 Acid*  
*POT 803*  
*No water*

RECORD

Cased 7 in., 3277 ft.

Sand ARB 3277

Gas \_\_\_\_\_

Oil \_\_\_\_\_

Total Depth 3289

PRODUCTION

1st 24 hrs. Nat. \_\_\_\_\_

1st 24 hrs. after shot \_\_\_\_\_

Gas \_\_\_\_\_ Cu. Ft.

Dry Hole \_\_\_\_\_

Abandoned \_\_\_\_\_

Date

JUN 15 1938

H. D. Hatfield