


Barton

KANSAS

Section 1 Township 20 Range 11-W

Well Number 7 Wm. Steckel

Company C.B. Davis et al

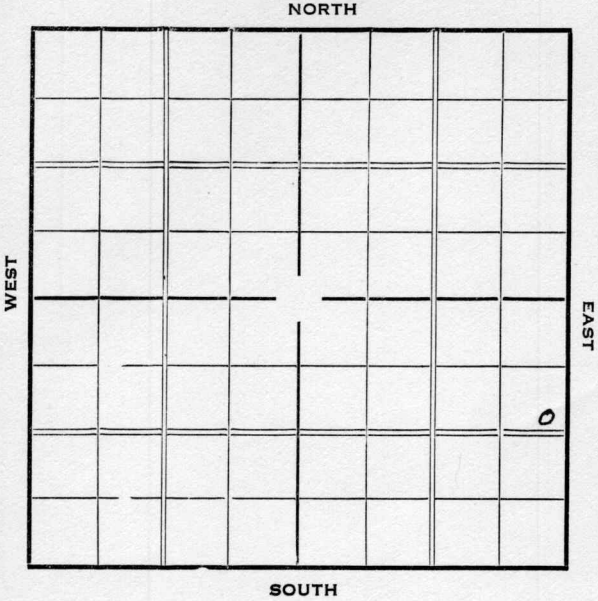

Map No. \_\_\_\_\_ Sec. 1 Twp. 20 R. 11-W

Well No. #7 Wm. Steckel Farm  
C. B. Davis et al Company


990 Ft. from N. Line

\_\_\_\_\_ Ft. from S. Line

330 Ft. from E. Line

\_\_\_\_\_ Ft. from W. Line

Elev. 1768

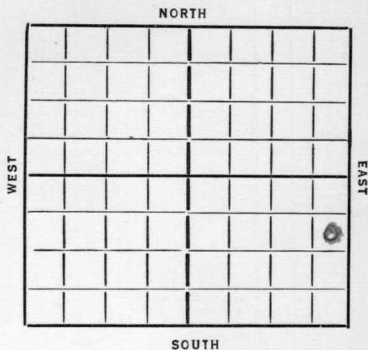

Date	REPORT
1936	
12/29	Cellar
1937	
1/7	Cellar
1/14	"
1/21	"
2/4	"
2/11	"
2/18	Rig
2/26	"
3/4	Rigging up.
3/11	12" @ 108 Drlg. 1423'.
3/18	Drlg. 2430'.
3/25	Drlg. 2950'.
4/2	7" @ 3258' RUST
4/8	Sil 3260' set 7" TD 3267' hole
	full oil 1 hr.
4/14	Sil. 3260'.
	T.D. 3268'.
	Potential 1229 natural.
	<b>COMPLETED</b>

Map No. \_\_\_\_\_ Sec. 1 Twp. 20 R. 11W.

Well No. 79m Steckel

C. B. Davis & Co Company

Contractor

**SECTION PLAT**

			0

990 Ft. from N. Line

\_\_\_\_\_ Ft. from S. Line

330 Ft. from E. Line

\_\_\_\_\_ Ft. from W. Line

**FIRST REPORT**

Location \_\_\_\_\_

Rig up \_\_\_\_\_

Drilling and Remarks:

Cellar.

**RECORD**

Cased \_\_\_\_\_ in., \_\_\_\_\_ ft.

Sand \_\_\_\_\_

Gas \_\_\_\_\_

Oil \_\_\_\_\_

Total Depth \_\_\_\_\_

**PRODUCTION**

1st 24 hrs. Nat. \_\_\_\_\_

1st 24 hrs. after shot \_\_\_\_\_

Gas \_\_\_\_\_ Cu. Ft.

Dry Hole \_\_\_\_\_

Abandoned \_\_\_\_\_

Date

DEC 29 1936 19

S. J. LEWIS

Scout

Map No. \_\_\_\_\_ Sec. 1 Twp. 20 R. 11W

Well No. 7 Wm Steckel

C. B. Davis & Gal Company

Contractor

**SECTION PLAT**

990 Ft. from N. Line

\_\_\_\_\_ Ft. from S. Line

300 Ft. from E. Line

\_\_\_\_\_ Ft. from W. Line

			o

**COMPLETED**

Location \_\_\_\_\_

Rig up \_\_\_\_\_

Drilling and Remarks:

*Sil 3260*

*Potential*

*1229 natural*

**RECORD**

Cased \_\_\_\_\_ in., \_\_\_\_\_ ft.

Sand \_\_\_\_\_

Gas \_\_\_\_\_

Oil \_\_\_\_\_

Total Depth 3268

**PRODUCTION**

1st 24 hrs. Nat. \_\_\_\_\_

1st 24 hrs. after shot \_\_\_\_\_

Gas \_\_\_\_\_ Cu. Ft.

Dry Hole \_\_\_\_\_

Abandoned \_\_\_\_\_

Date

APR 14 1937 19

S. J. LEWIS Scout