


Section 1 Township 20 Range 11-W


Well Number 9 W. Steckel

Company C.B. Davis et al

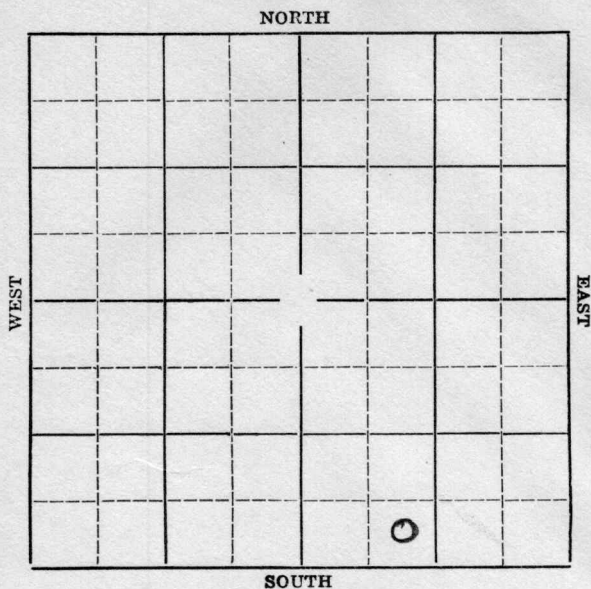

Sec. 1 Twp. 20 R. 11-WWell No. #9 W. Steckel Farm
C. B. Davis et al Company Ft. from N. Line330 Ft. from S. Line Ft. from E. Line990 Ft. from W. Line

Elev. 1760

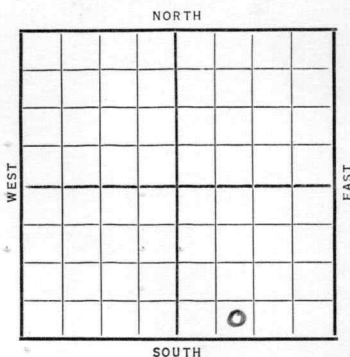

Date

REPORT

1937

3/3

Rig

3/11

"

3/18

"

3/25

"

4/2

"

4/8

"

4/16

"

4/23

"

4/30

12" @ 100'. Drlg. 325'.

5/7

Drlg. 2055'.

5/14

Drlg. 2870'.

5/21

Sil. 3261'. T.D. 3261½'.

Rng. 7".

5/28

T.D. 3272'. H.F.O.

OVER

1937

6/2

7" @ 3261'.

Sil. 3261'.

T.D. 3272'.

Pot. 1401 bbls.

(389 bbls. 6 hrs)

COMPLETED

KANSAS

Map No. 46 Sec. 1 Twp. 20 R. 11WWell No. 9 W. StechelC. B. Davis & Co. Company

Contractor

SECTION PLAT

 Ft. from N. Line330 Ft. from S. Line Ft. from E. Line990 Ft. from W. Line

FIRST REPORT

Location Rig up

Drilling and Remarks:

Rig○
○ ○

RECORD

Cased in., ft.Sand Gas Oil Total Depth

PRODUCTION

1st 24 hrs. Nat. 1st 24 hrs. after shot Gas Cu. Ft.Dry Hole Abandoned

Date

MAR 3 1937

19

S. J. LEWIS Scout

Barton KANSASMap No. _____ Sec. 1 Twp. 20 R. 11 ^WWell No. 9-W. StuckelDavis et al Company

Contractor _____

COMPLETED

SECTION PLAT

			0

_____ Ft. from N. Line

330 Ft. from S. Line

_____ Ft. from E. Line

990 Ft. from W. Line

Location _____

Rig up _____

Drilling and Remarks:

*Rot - 1401**(389/6 hrs)*

RECORD

Cased 7 in., 3261 ft.Sand Sil - 3261

Gas _____

Oil _____

Total Depth 3272

PRODUCTION

1st 24 hrs. Nat. _____

1st 24 hrs. after shot _____

Gas _____ Cu. Ft.

Dry Hole _____

Abandoned _____

Date

JUN 2 1937 19

H. D. Hatfield

Scout