Barton


FORM 51 10M 8-47

KANSAS

Section 24 Township 18 Range 11-W

Well No. #1 Roesler

Company Mid-Plains & Dervy Oil

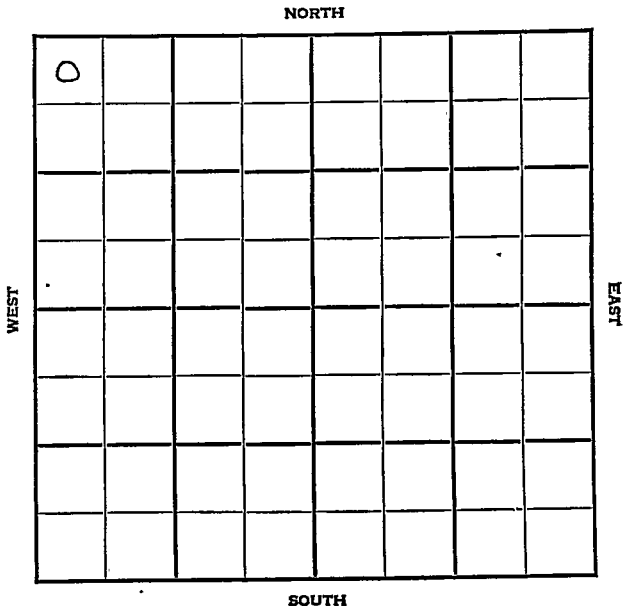

FORM 252-A
5M 4-48 PETROL

KANSAS

Barton ✓

Sec. 24 Twp. 18 R. 11W

Well No. #1 Roesler Farm

Mid-Plains & Derby Oil Company

Wildcat


330' Ft. from N. Line

_____ Ft. from S. Line

_____ Ft. from E. Line

330' Ft. from W. Line

NW/C

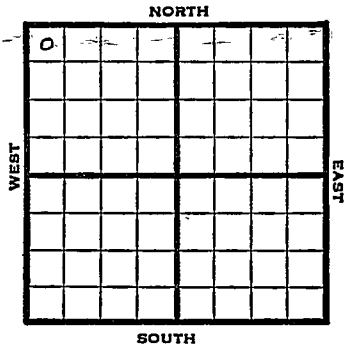

1948	Eli 1776' REPORT
7/14	RUR
7/21	8"@ 350' Drlg 2876'
7/28	Arb. 3307' 5"@ 3307' TD 3315'
8/4	Arb. 3307' TD 3315' Aband.

ABANDONED

Form 26—200 Bks.—1-48—Palace

Kansas

Wildcat

Map No. _____ Sec. 24 Twp. 18 R. 11 W

Well No. 1 Roesler

Mid-Plains & Derby Oil Company

FIRST REPORT Contractor

NW/C


330 Ft. from N. Line

_____ Ft. from S. Line

_____ Ft. from E. Line

330 Ft. from W. Line

SECTION PLAT

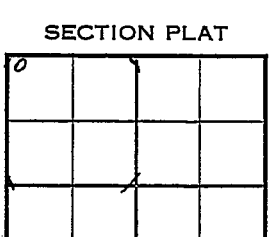

Barton County

Location _____

Rig up _____

Drilling and Remarks:

RUR

RECORD

Cased _____ in., _____ ft.

Sand _____

Gas _____

Oil _____

Total Depth _____

PRODUCTION

1st 24 hrs. Nat. _____

1st 24 hrs. after shot _____

Gas _____ Cu. Ft.

Dry Hole _____

Abandoned _____

Date

JUL 14 1948 19____ S. J. LEWIS Scout

Form 27—100 Bks.—4-48—Petrol

Barton County Kansas State

Map No. 15 Sec. 24 Twp. 18 R. 11W

Well No. 1 Roesler


Mid-Plains & Derby Oil Company

ABANDONED Contractor

NW/C

E. 1796

SECTION PLAT

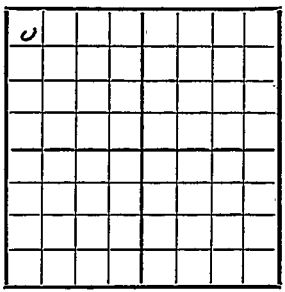

330 Ft. from N. Line

Ft. from S. Line

Ft. from E. Line

330 Ft. from W. Line

Wildcat

Remarks:

Ar #33307

KID 33315

Date AUG 4 1948

Scout S. J. LEWIS