
Barton KANSAS

SECTION 24 TOWNSHIP 18 RANGE 11W

WELL NO. #3 Roesler

COMPANY Colorado Oil & Gas

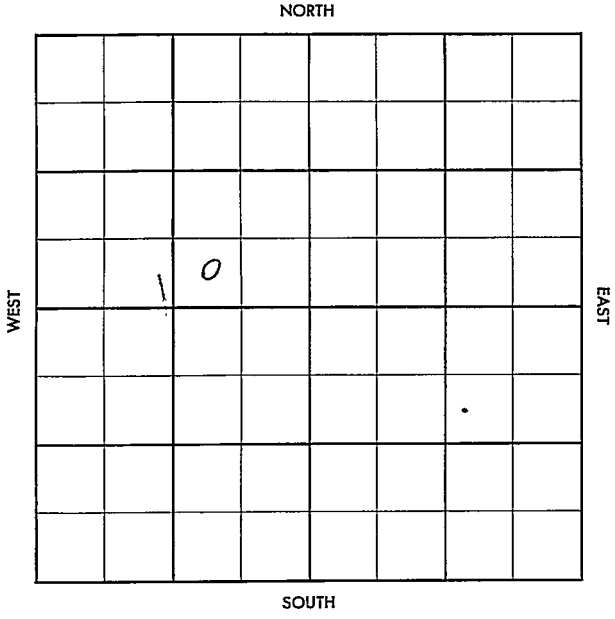

Barton **KANSAS**

SEC.	TWP.	R.
24	18	11W

WELL NO.

#3 Roesler FARM

COMPANY

Colorado Oil & Gas

CONTRACTOR

Peel Bros.

Meadowside


_____ Ft. from N. Line

_____ Ft. from S. Line

_____ Ft. from E. Line

_____ Ft. from W. Line

SW SE NW

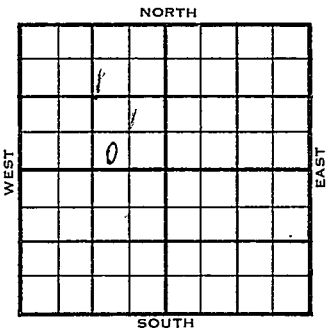

1956	ELEVATION 1759	REPORT
4-18	Comm. 4-14-56 8" @ 250 w/150 Drlg. 1514 Anh. 540	
5-2	DST 2998-3050 op 1 hr. rec. 45' mud., BHP 1160/30" DST 3067-88 op 1 hr. rec. 45' mud, BHP 500/30" DST 3195-3235 op 1 hr. rec. 35' SOCM & 100' G&WCM, BHP 1075/20" DST 3289-97 op 1 hr. rec. 62' WM, BHP 610/30" DST 3295-3325 op 1 hr. rec. 1362' SW, BHP 1110/30" D&A H. 2856 BL 2971 L. 2988 BKC 3236 A. 3284 TD 3325	

ABANDONED

DX-78

FORM 513 SUNRAY

County Benton Elev.

Sec. 24 Twp. 18 Rge. 11W

Company Colorado Oil & Gas

Farm Name Roesler No. 3

TOPS	DEPTH	LOG	DATUM
Anh.	540		
T.P.			
H.			
Tr.			
Dg.			
B.L.			
L.			
K.C.			
B.K.C.			
Ce.			
C.			
M.			
M.			
K.			
Mz.			
Mo.			
V.			
S.			
S.			
A			
R.			
P€.			
G.			
T.D.			

Loc. in Sec. SW SE NW

Geol.

Contr. Peel Bros.

Pool Meadowside



Date Comm. 4-14-56

8" @ 250/150 drlg. 1514

Co. Lse. No. Sec. T. R.

APR 23 1956

13

FORM 513 SUNRAY

Co.

County Barton Elev. 1759

Sec. 24 Twp. 18 Rge. 11W

Company Colorado Oil & Gas

Farm Name Roesler No. 3

TOPS	DEPTH	LOG	DATUM
Anh.	540		
Tp.			
H.	2856		
Tr.			
Dg.			
Bl.	2971		1212
L.	2988		1229
K.C.			
B.K.C.	3236		1477
Ce.			
C.			
M.			
M.			
K.			
Mz.			
Mo.			
V.			
S.			
S.			
A	3284		1525
R.			
P€.			
G.			
T.D.	3325		


Loc. in Sec. SW SE NW

Geol.

Contr. Peel Bros.

Lse.

Pool Meadowside

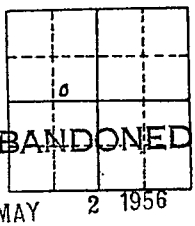

ABANDONED

MAY 2 1956

No.

Date Comm. 4-14-56

Sec.

8" @ 250/150 Drlg. 1514 APR 25 '56 DST

2998-3050 1hr rec 45' Md

BHP 1160/30 DST 3067-88

1hr rec 45' Md BHP 500/30

DST 3195-3235 1hr rec 35'

SOCM + 100' G&WCM BHP 1075/20

DST 3289-97 1hr rec 62' WM BHP

610/30" MAY 2 '56 DST 3295-3325

1hr 1362' SW BHP 1110/30"

D&A

T.

R.