


Section 24 Township 18 Range 11W

Well No. #1 Stumps "B"

Company Petroleum Inc.

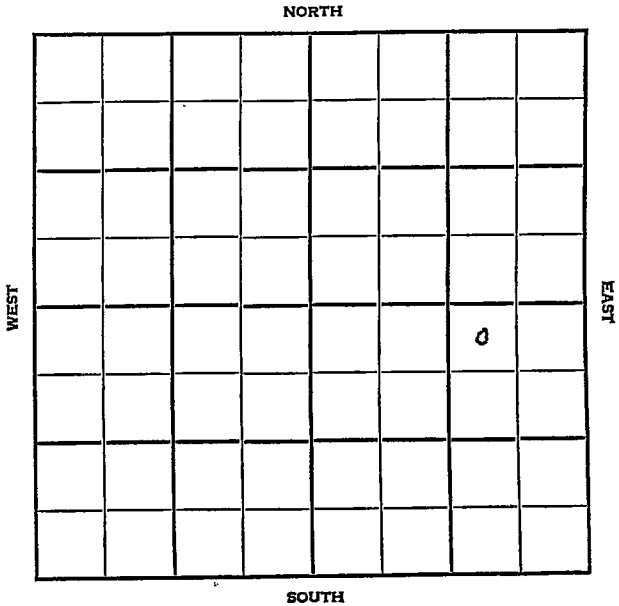

SEC.	TWP.	R.
24	18	11W

WELL NO. #1 Stumps "B" FARM

COMPANY Petroleum Inc.

CONTRACTOR Garvey

Meadowside Pool

330 Ft. from N. Line

Ft. from S. Line

990 Ft. from E. Line

Ft. from W. Line

NW NE SE

1954	ELEVATION	REPORT
	1773'	

10/13 Spud 10-8-54  
8" @ 224'  
Anhy 543'  
Drlg. 2595'

10/20 Spud 10-8-54 - D&A  
TD 3310'  
8" @ 224'  
Anhy 543', Br line 2977', Lans 2995'  
DST 3080-85', opn 1 hr., rec. 115'  
SOCM, 475#  
Cong. 3279', Arb. 3307'  
TD 3310'  
D&A

**ABANDONED**

County Barton State Kansas

Sec. 24 (Blk.) 18 (Sur.) 11W Map No.

Operator Petroleum Inc.

Well No. 1 Farm Stumps "B"

Elev. Location NW NE SE


FIRST REPORT

330 Ft. From N Line SE

990 Ft. From E Line Quarter

1st. Report OCT 13 1954

Completion

Remarks

Garvey - Contr.

Spudding Date 10-8-54

Drlg. Data Meadowside Pool

8" @ 224 Anhy 543 drlg. 2595

FABEN GILSTRAP


County Barton State Kansas

Sec. 24 (Blk. Twp.) 18 (Sur. Rge.) 11W Map No.

Operator Petroleum Inc.

Well No. 1 Farm Stumps "B"

Elev. 1773 Location NW NE SE

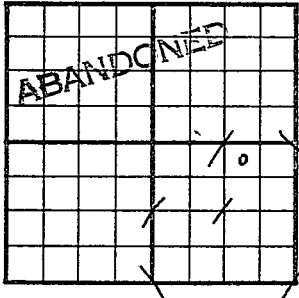

330 Ft. From N Line SE

990 Ft. From E Line Quarter

Ist. Report

Completion OCT 20 1954

Remarks Meadowside Pool

Garvey - Contr.

Spudding Date 10-8-54

Drilg. Data D & A TD 3310

8" @ 224 Anhy 543 Br. lime 2977

Lans. 2995 DST 3080-85 open 1 hr. Rec.

115' socm 475# Cong. 3279 Arb. 3307

TD 3310

D & A

FABEN GILSTRAP