


Barton

Section 2 Township 20 Range 11-W


Well No. 1 John Dick

Company Stanolind

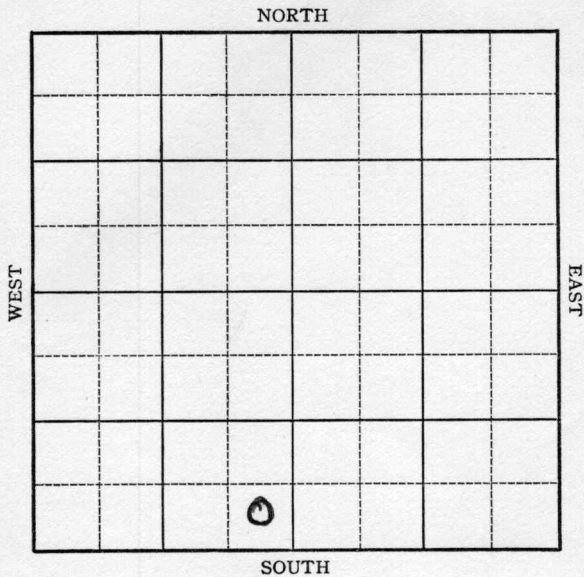

Sec. 2 Twp. 20 R. 11-WWell No. #1 John Dick FarmStanolind Company Ft. from N. Line330 Ft. from S. Line330 Ft. from E. Line Ft. from W. Line

Elev. 1760

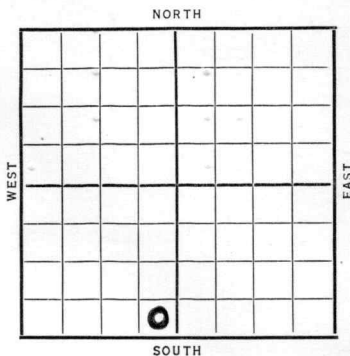

Date

REPORT

1937

5/26 Location

6/4 "

6/11 "

6/19 R. R.

6/25 Mat.

7/2 13" @ 185'. Anhy 470'.

Drlg. 1877'.

7/9 Lans. 3030'. Drlg. 3197'.

7/16 Sil. 3264'. 6" @ 3264'.

Sat. Core 3265-70'. RUST.

7/23 Flowed 37½ bbls. P.H. for

7 hrs. Then pumped 1378

in 14 hrs.

7/30 " "

OVER

1937

8/4

6" @ 3264'.

Sil. 3264'.

T.D. 3270'.

Pot. 2016 bbls. 24 hrs. Nat.

COMPLETED

Barton KANSASMap No. _____ Sec. 2 Twp. 20 R. 11 WWell No. 1 - John DickStanolind Company

Contractor _____

FIRST REPORT

SECTION PLAT

_____ Ft. from N. Line

330 Ft. from S. Line330 Ft. from E. Line

_____ Ft. from W. Line

Location ✓

Rig up _____

Drilling and Remarks:

RECORD

Cased _____ in., _____ ft.

Sand _____

Gas _____

Oil _____

Total Depth _____

PRODUCTION

1st 24 hrs. Nat. _____

1st 24 hrs. after shot _____

Gas _____ Cu. Ft.

Dry Hole _____

Abandoned _____

Date

MAY 26 1901

19

H. D. Hatfield

Scout

Barton KANSASMap No. _____ Sec. 2 Twp. 20 R. 11 WWell No. 1 - John DickStanolind Company

Contractor _____

COMPLETED

SECTION PLAT

_____ Ft. from N. Line

330 Ft. from S. Line330 Ft. from E. Line

_____ Ft. from W. Line

Location _____

Rig up _____

Drilling and Remarks:

RECORD

Cased 6 in., 3264 ft.Sand 511 3264

Gas _____

Oil _____

Total Depth 3270

PRODUCTION

1st 24 hrs. Nat. _____

1st 24 hrs. after shot _____

Gas _____ Cu. Ft.

Dry Hole _____

Abandoned _____

Date

AUG 4 - 1937 19H. D. Hatfield Scout

Pat - 2016/24
nat.