

Barton


KANSAS

FORM 51 5M PETROL

Section 25 Township 18- Range 11-W

Well No. #1 Ames

Company Sohio

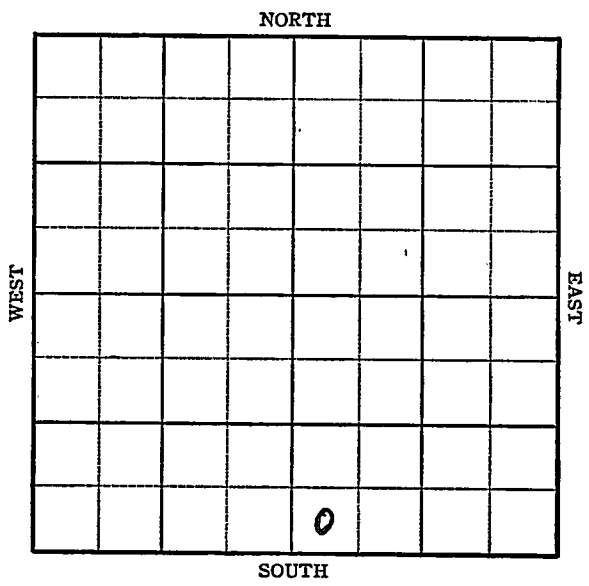

Sec. 25 Twp. 18 R. 11^W

Well No. #1 Ames Farm


Sohio Company

 Ft. from N. Line

330 Ft. from S. Line

 Ft. from E. Line

330 Ft. from W. Line

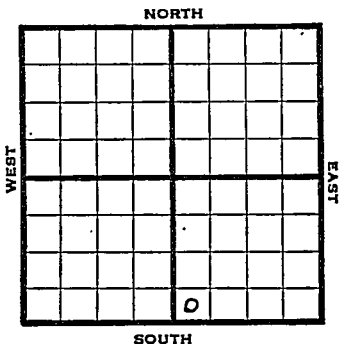

SW SE

1945 Elev. 1748' REPORT

12/12 RUR

12/20 8" - 354' WOC.

12/29 Drlg. 2730'

1946

1/9 Lans. 2991

Arb. 3313

TD 3330'

ABANDONED

KANSAS

Kansas Pool Name WildcatMap No. 2155 Sec. 25 Twp. 18 R. 11WWell No. 1 AmesSohio

Company

FIRST REPORT

Contractor

SW SE

SECTION PLAT

 Ft. from N. Line330 Ft. from S. Line Ft. from E. Line330 Ft. from W. Line

Barton CountyLocation Rig up

Drilling and Remarks:

RUR

RECORD

Cased in., ft.Sand Gas Oil Total Depth

PRODUCTION

1st 24 hrs. Nat. 1st 24 hrs. after shot Gas Cu. Ft.Dry Hole Abandoned

Date

DEC 12 1945 19S. I. LEWIS Scout

KANSAS Kansas Pool Name Wildcat

Map No. 57 Sec. 25 Twp. 18 R. 11W

Well No. 1 Ames

Sohio Company

ABANDONED Contractor

SW SE

E. 1248

SECTION PLAT

_____ Ft. from N. Line

330 Ft. from S. Line

_____ Ft. from E. Line

330 Ft. from W. Line

Barton County

Location _____

Rig up _____

Drilling and Remarks:

Zone 2991
Per X2369

RECORD

Cased _____ in., _____ ft.

Sand _____

Gas _____

Oil _____

Total Depth 330

PRODUCTION

1st 24 hrs. Nat. _____

1st 24 hrs. after shot _____

Gas _____ Cu. Ft.

Dry Hole _____

Abandoned _____

Date

JAN 9 1946 19

S. J. LEWIS Scout