

KANSAS

Barton

Section 24 Township 18 Range 11WWell No. 2 RoeslerCompany Derby et alBloomer
NORTH

			0				

WEST

EAST

SOUTH

Barton

KANSAS ✓

Sec. 24 Twp. 18 R. 11W

Well No. #2 Roesler Farm _____

Darby et al Company _____

Bloomer Pool (Peel, Cont.)

NORTH

_____ Ft. from N. Line

330'


_____ Ft. from S. Line

330'

_____ Ft. from E. Line

_____ Ft. from W. Line

SE NW

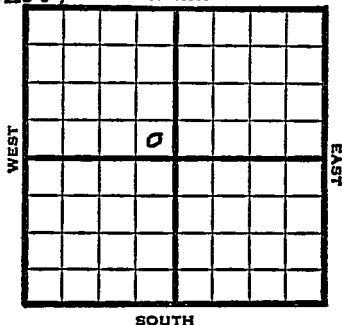

1949 Elev. 1758' REPORT

8/3 8" @ 157'

Drlg. 1340'

8/10 Lansing 2985'

Arb. 3270'

TD 3273'

4" @ 3271'

8/17 TD 3283'

Swb 101 bbls oil 3 hrs.

8/24 "

8/31 "

9/7 Arb 3270'

4" @ 3271'

500 acid

Pump 444 oil Pot.

Grav. 42

TD 3283'

COMPLETED

Kansas

Bloomer Pool

Map No. _____ Sec. 24 Twp. 18 R. 11WWell No. 2 Roesler

Derby et al. _____ Company

Peel _____ Contractor


SE NW

FIRST REPORT
SECTION PLAT

_____ Ft. from N. Line

330 Ft. from S. Line330 Ft. from E. Line

_____ Ft. from W. Line

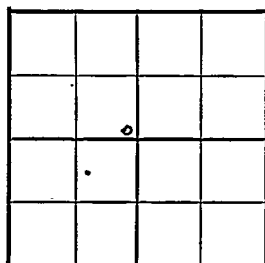

Barton County

Location _____

Rig up _____

Drilling and Remarks:

8" @ 157

1340

RECORD

Cased _____ in., _____ ft.

Sand _____

Gas _____

Oil _____

Total Depth _____

PRODUCTION

1st 24 hrs. Nat. _____

1st 24 hrs. after shot _____

Gas _____ Cu. Ft.

Dry Hole _____

Abandoned _____

Date

AUG 3 1949

19

S. J. LEWIS

Scout

Kansas

Map No. K55 Sec. 24 Twp. 18 R. 11WWell No. 2 Roesler


Derby et al.

Company

COMPLETE

Contractor

SE NW

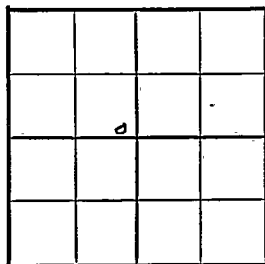E 11 1/2 S
SECTION PLAT

Ft. from N. Line

330 Ft. from S. Line330 Ft. from E. Line

Ft. from W. Line

Barton County

Location

Rig up

Drilling and Remarks:

*Per 3270**4' 3271**5000 acid**Prod 444 oil Bx**420 lb*

RECORD

Cased _____ in., _____ ft.

Sand _____

Gas _____

Oil _____

Total Depth 3273

PRODUCTION

1st 24 hrs. Nat. _____

1st 24 hrs. after shot _____

Gas _____

Cu. Ft. _____

Dry Hole _____

Abandoned _____

Date

SEP 7 1949

19

S. J. LEWIS

Scout