


KANSAS

Barton

Section 2 Township 20 Range 11-W

Well Number #1 Chris Arensdorf

Company Stanolind

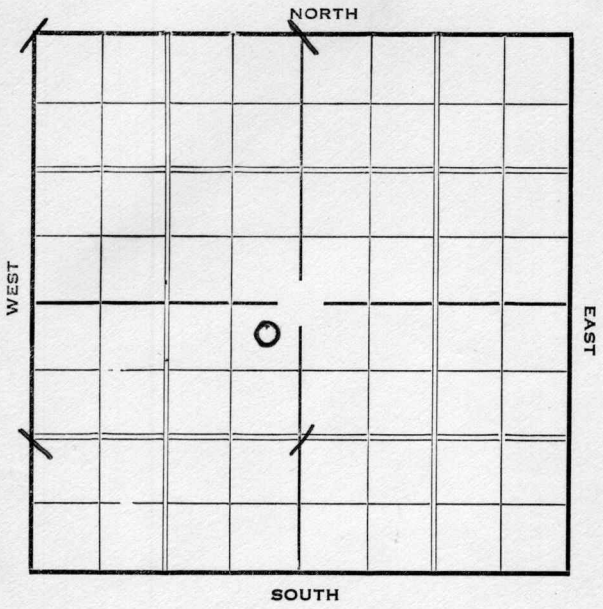

KANSAS

Barton

Map No. _____ Sec. 2 Twp. 20 R. 11 W

Chris

Well No. 1 - Aensdorf

Stanaland Company

Contractor

FIRST REPORT

SECTION PLAT

330 Ft. from N. Line

_____ Ft. from S. Line

330 Ft. from E. Line

_____ Ft. from W. Line

	0		

Location ✓

Rig up _____

Drilling and Remarks:

RECORD

Cased _____ in., _____ ft.

Sand _____

Gas _____

Oil _____

Total Depth _____

PRODUCTION

1st 24 hrs. Nat. _____

1st 24 hrs. after shot _____

Gas _____ Cu. Ft.

Dry Hole _____

Abandoned _____

Date

JUN 30 1937 19

H. D. Hatfield

Scout

Barton KANSASMap No. _____ Sec. *2* Twp. *20* R. *11* ^WWell No. *1 - Chris Arensdorf**Stanolind* Company

Contractor _____

COMPLETED

SECTION PLAT

330 Ft. from N. Line

_____ Ft. from S. Line

330 Ft. from E. Line

_____ Ft. from W. Line

	0		

Location _____

Rig up _____

Drilling and Remarks:

*2000 Acid**Pot - 1229*

RECORD

Cased *6* in., *3293* ft.Sand *511 3292*

Gas _____

Oil _____

Total Depth *3304*

PRODUCTION

1st 24 hrs. Nat. _____

1st 24 hrs. after shot _____

Gas _____ Cu. Ft.

Dry Hole _____

Abandoned _____

Date

AUG 11 1937 19 *H. D. Hatfield* Scout