
FORM 51 25M 3-49 PETROL KANSAS Barton

Section 24 Township 18 Range 11W

Well No. 1 Stumps "B"

Company ~~Eldorado Ref. et al~~ Wildcat

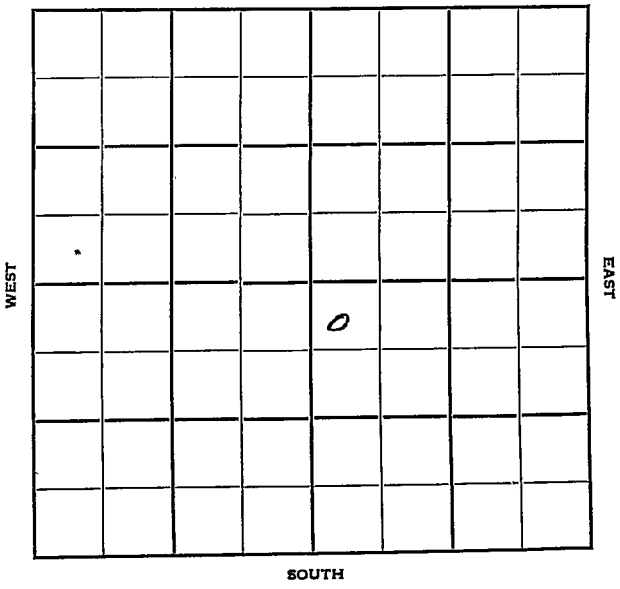

FORM 252-A
5M 10-48 PETROL

KANSAS

Sec. 24 Twp. Barton 18 R. 11W ✓

Well No. #1 Stumps "B" Farm

Eldorado Ref. et al Company

Wildcat (Florney & Williams Cont.)


330' Ft. from N. Line

Ft. from S. Line

Ft. from E. Line

330' Ft. from W. Line

NW SE

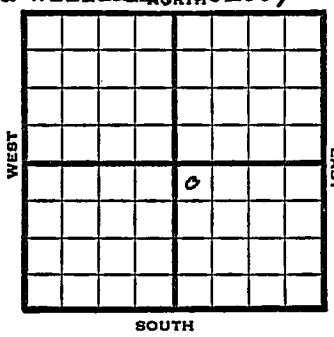

1949	Elev 1772' REPORT
6/15	Location
6/21	"
6/28	8"@ 172' Drlg 2265'
7/6	Lansing 2996' Arbuckle 3286' TD 3299' 5" @ 3285'
7/12	"
7/20	Swb 60 bbls oil PH
8/27	"
8/3	TD 3299' Arb. 3283' 5"@ 3285' Echo Pot 3000 Oil 42° Gr. Comp
	COMPLETED

Form 27—100 Bks.—4-48—Petrol

Barton County Kansas State

Map No. Sec. 24 Twp. 18 R. 11W

Well No. 1 Stumps "B"


Eldorado Ref. etal. Company

Florney & Williams Contractor

NW SE

FIRST REPORT

SECTION PLAT

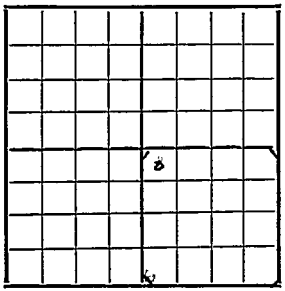

330 Ft. from N. Line

Ft. from S. Line


Ft. from E. Line

330 Ft. from W. Line

Wildcat

Remarks:

Location

 

Date JUN 1 5 1949

Scout S. J. LEWIS

Form 26 200 Bks. 6-49 Petrol

Kansas Wildcat

Map No. K-55 Sec. 24 Twp. 18 R. 11W

Well No. 1 Stumps "B"


Eldorado Ref. etal. Company

COMPLETE Contractor

NW SE

E 1,1772

SECTION PLAT

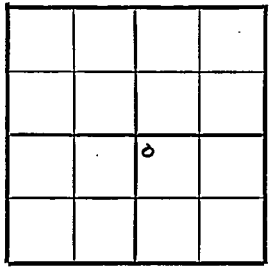

330 Ft. from N. Line

____ Ft. from S. Line

____ Ft. from E. Line

330 Ft. from W. Line

Barton County

Location

Rig up

Drilling and Remarks:

Cer 3283

5" @ 3283

Ec to RTD 3000 oil

42 gr

RECORD

Cased ____ in., ____ ft.

Sand

Gas

Oil

Total Depth 3299

PRODUCTION

1st 24 hrs. Nat.

1st 24 hrs. after shot

Gas Cu. Ft.

Dry Hole

Abandoned

Date

AUG 3 1949 19

S. J. LEWIS Scout