


Barton

KANSAS

Section 2 Township 20 Range 11-W

Well No. #5 Fred Panning

Company Stanolind

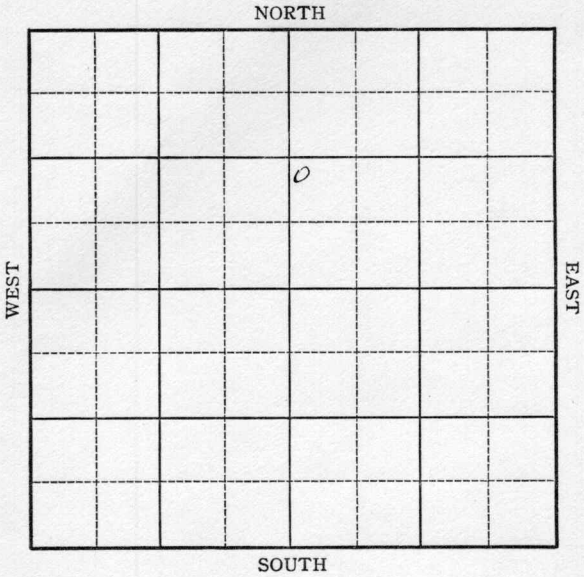

1937

11/23 6" @ 3285'.

Sil. 3285'.

T.D. 3305'.

2000 acid.

P.B. 3303'.

Potential 1886 bbls.

COMPLETED

Barton KANSAS

Map No. _____ Sec. 2 Twp. 20 R. 11WWell No. 5 Fred PanningStanolind

Company

Contractor

FIRST REPORT

NW SW NE

____ Ft. from N. Line

990 Ft. from S. Line

____ Ft. from E. Line

330 Ft. from W. Line

SECTION PLAT

		0	

Location _____

Rig up _____

Drilling and Remarks:

Cellar

RECORD

Cased _____ in., _____ ft.

Sand _____

Gas _____

Oil _____

Total Depth _____

PRODUCTION

1st 24 hrs. Nat. _____

1st 24 hrs. after shot _____

Gas _____ Cu. Ft.

Dry Hole _____

Abandoned _____

Date

SEP 29 1937 19 _____ H. D. Hatfield Scout

Barton

KANSAS

Map No. 46 Sec. 2 Twp. 20 R. 11WWell No. 5 Fred PanningStanolind

Company

Contractor

COMPLETED

NW SW NE

 Ft. from N. Line990 Ft. from S. Line Ft. from E. Line330 Ft. from W. Line

SECTION PLAT

		0	

Location Rig up

Drilling and Remarks:

2000 AcidP.B. 3303POT-1886

RECORD

Cased 6 in., 3285 ft.Sand 511 3285Gas Oil Total Depth 3305

PRODUCTION

1st 24 hrs. Nat. 1st 24 hrs. after shot Gas Cu. Ft.Dry Hole Abandoned

Date

NOV 23 1937 19H. D. Hatfield

Scout