


Barton

KANSAS

Section 2 Township 20 Range 11-W

Well No. 11 Fred Panning

Company Stanolind

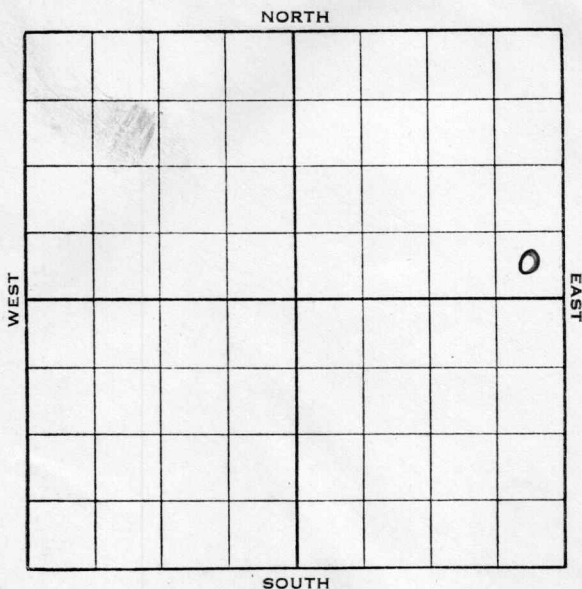


KANSAS

Barton

Sec. 2 Twp. 20 R. 11-WWell No. #11 Fred Panning Farm
Stanolind Company Ft. from N. Line330 Ft. from S. Line330 Ft. from E. Line Ft. from W. Line

Elev. 1766

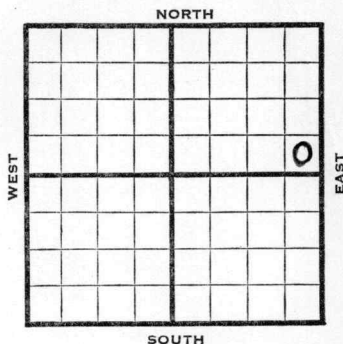

1938	REPORT
4/13	R.R.
4/22	10" @ 205'. Anhy 470'.
	Drlg. 1000'.
4/29	Drlg. 2736'.
5/6	Arb. 3272-76' T.D. Sat. Core.
	Running csg.
5/12	6" @ 3272'. Drilled plug.
	600' oil in 2 hrs.
	Deepened to 3281'.
	Swabbing 6 oil per hour.
5/18	6" @ 3272'.
	Arb. 3272'.
	T.D. 3281'.
	5000 acid.
	Potential 2035 bbls.
	COMPLETED

Map No. 46 Sec. 2 Twp. 20 R. 11WWell No. 11 Fred PanningStanolind

Company

Contractor

FIRST REPORT

SE NE

 Ft. from N. Line330 Ft. from S. Line330 Ft. from E. Line Ft. from W. Line

SECTION PLAT

			0

Location Rig up

Drilling and Remarks:

RR

RECORD

Cased in., ft.Sand Gas Oil Total Depth

PRODUCTION

1st 24 hrs. Nat. 1st 24 hrs. after shot Gas Cu. Ft.Dry Hole Abandoned

Date

APR 13 1938

19

H. D. Hatfield

Scout

Barton

KANSAS

Map No. 46 Sec. 2 Twp. 20 R. 11WWell No. 11 Fred PanningStanolind

Company

Contractor

COMPLETED

SE NE

 Ft. from N. Line330 Ft. from S. Line330 Ft. from E. Line Ft. from W. Line

SECTION PLAT

			0

Location Rig up

Drilling and Remarks:

5000 andPOT 2035

RECORD

Cased 6 in., 3272 ft.~~Sand~~ Ark 3272Gas Oil Total Depth 3281

PRODUCTION

1st 24 hrs. Nat. 1st 24 hrs. after shot Gas Cu. Ft.Dry Hole Abandoned

Date

MAY 18 1938 19

H. D. Hatfield

Scout