

Barton

Section 2 Township 20 Range 11-WWell No. 12 Fred PanningCompany Stanolind

							0

NORTH

WEST

EAST

SOUTH

KANSAS

Barton


Sec. 2 Twp. 20 R. 11-WWell No. #12 Fred Panning Farm
Stanolind Company

Ft. from N. Line

990 Ft. from S. Line330 Ft. from E. Line

Ft. from W. Line

Elev. 1766'

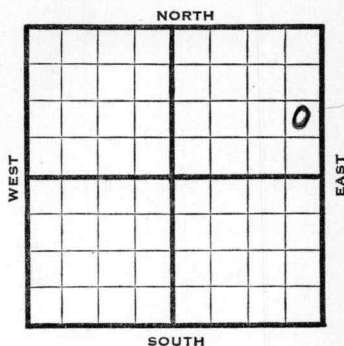

1938	REPORT
6/15	B.R.R.
6/24	R U R
7/1	10" - 212' Drlg. 1391'
7/8	Drlg. 2672'.
7/15	Arb. 3272-76' T.D. S.O.
	6" - 3272'. RUST.
7/20	6" - 3270'.
	Arb. 3270(Corrected)
	T. D. 3278'.
	3000' oil 2 hrs.
	2000 acid.
	Pump 307 bbls. in 4 hrs. & 296
	barrels in 4 hrs.
	Potential 1776 bbls. No wtr.
	COMPLETED

Barton KANSAS

Map No. 46 Sec. 2 Twp. 20 R. 11WWell No. 12 Fred PanningStanolind

Company

Contractor

FIRST REPORT

NE SE NE

Ft. from N. Line

990

Ft. from S. Line

330

Ft. from E. Line

Ft. from W. Line

SECTION PLAT

			0

Location _____

Rig up _____

Drilling and Remarks:

BRR

RECORD

Cased _____ in., _____ ft.

Sand _____

Gas _____

Oil _____

Total Depth _____

PRODUCTION

1st 24 hrs. Nat. _____

1st 24 hrs. after shot _____

Gas _____ Cu. Ft.

Dry Hole _____

Abandoned _____

Date

JUN 15 1938

19

H. D. Hatfield Scout

Barton

KANSAS

Map No. 46 Sec. 2 Twp. 20 R. 11WWell No. 12 Fred PanningStanolind

Company

Contractor

COMPLETED

NE SE NE

Ft. from N. Line

990 Ft. from S. Line330 Ft. from E. Line

Ft. from W. Line

SECTION PLAT

			0

Location _____

Rig up _____

Drilling and Remarks:

3000' oil - 2 hrs2000 AcidPump 307/4 + 296/4POT 1776NO WT

RECORD

Cased 6 in., 3270 ft.Sand Arb 3270Gas (Corrected)

Oil _____

Total Depth 3278

PRODUCTION

1st 24 hrs. Nat. _____

1st 24 hrs. after shot _____

Gas _____ Cu. Ft.

Dry Hole _____

Abandoned _____

Date

JUL 20 1938 19H. D. Hatfield

Scout