


Barton

KANSAS

Section 2 Township 20 Range 11-W

Well No. 17 Fred Panning

Company Stanolind

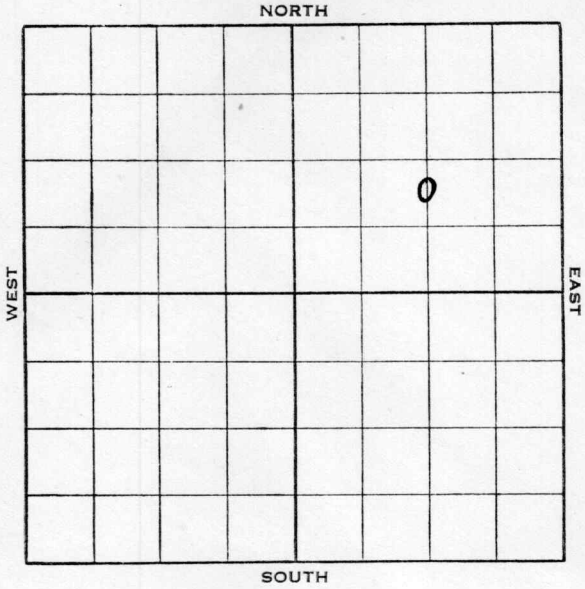

Map No. _____ Sec. 2 Twp. 20 R. 11W

Well No. 17 Fred Panning

Stanolind Company

Contractor _____

ABANDONED

SECTION PLAT

C N L S $\frac{1}{2}$ NE

		0	

_____ Ft. from N. Line

990 Ft. from S. Line

1320 Ft. from E. Line

_____ Ft. from W. Line

Location _____

Rig up _____

Drilling and Remarks:

*20 gts
4000 acid*

RECORD

Cased 7 in., 3284 ft.

Sand 4-6 3284

Gas _____

Oil _____

Total Depth 3303

PRODUCTION

1st 24 hrs. Nat. _____

1st 24 hrs. after shot _____

Gas _____ Cu. Ft.

Dry Hole _____

Abandoned _____

Date

NOV 9 - 1938 19

H. D. Hatfield Scout