
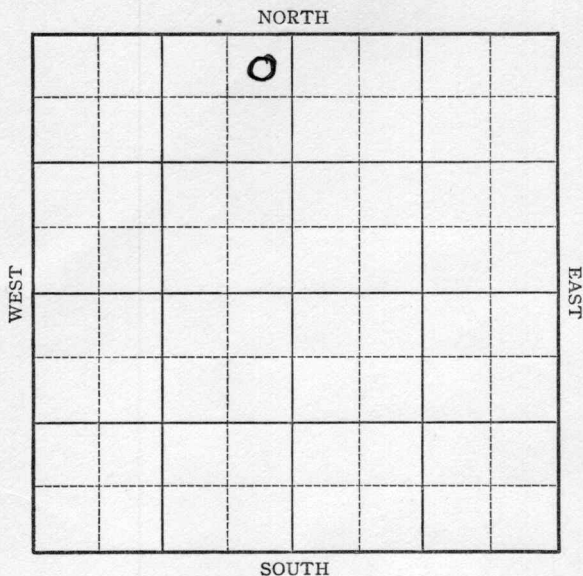


Section 2 Township 20 Range 11-WWell No. 3 ~~Chris Arensdorf~~ *A. Scharfz*Company Stanolind

Sec. 2 Twp. 20 R. 11-WWell No. #3 A. Schartz
Chris Arendorf FarmStanolind Company330 Ft. from N. Line Ft. from S. Line330 Ft. from E. Line Ft. from W. Line

Elev. 1767

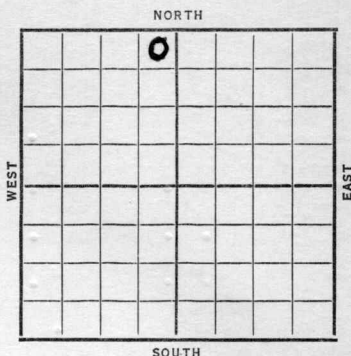

Date

REPORT

1937

9/8

Rig. up.

9/17

R. U.

9/24

Rig.

10/2

"

10/8

S. H.

10/15

10" @ 221'. Drlg. 1830'.

10/22

Drlg. 3120'.

10/29

Sil. 3286 & 6". T.D. 3292'.

1300' oil 6 hrs. C.O.

11/5

T.D. 3310'. 6000 acid.

Swabbing 11 bbls. oil P.H. off
bottom.

11/12

Pot. 315'. T.D. 3316' S.W.

P.B. 3314'.

OVER

1937

11/17 6" @ 3286'.

Sil. 3286'.

T.D. 3316'.

P.B. 3314'.

6000 acid.

Potential 315 bbls.

COMPLETED

Map No. _____ Sec. 2 Twp. 20 R. 11WWell No. 3-^{Chris} AensdorfStanolind Company

Contractor

FIRST REPORT

SECTION PLAT

	0		

330 Ft. from N. Line

_____ Ft. from S. Line

330 Ft. from E. Line

_____ Ft. from W. Line

Location _____

Rig up ☒

Drilling and Remarks:

RECORD

Cased _____ in., _____ ft.

Sand _____

Gas _____

Oil _____

Total Depth _____

PRODUCTION

1st 24 hrs. Nat. _____

1st 24 hrs. after shot _____

Gas _____ Cu. Ft.

Dry Hole _____

Abandoned _____

Date

SEP 8 1937

19

H. D. Hatfield

Scout

*Barton*Map No. _____ Sec. 2 Twp. 20 R. 11 WWell No. 3-a. ScharzStanolind

Company

Contractor

CORRECTION

SECTION PLAT

330 Ft. from N. Line

_____ Ft. from S. Line

330 Ft. from E. Line

_____ Ft. from W. Line

	0		

Location _____

Rig up _____

Drilling and Remarks:

farm name
Changed from
3 Chris
arensdorf

RECORD

Cased _____ in., _____ ft.

Sand _____

Gas _____

Oil _____

Total Depth _____

PRODUCTION

1st 24 hrs. Nat. _____

1st 24 hrs. after shot _____

Gas _____ Cu. Ft.

Dry Hole _____

Abandoned _____

Date

SEP 15 1887 19

H. D. Hatfield Scout

Barton

KANSAS

Map No. _____ Sec. 2 Twp. 20 R. 11WWell No. 3 A. SchartzStanolind Company

Contractor

COMPLETED

NE NW

330 Ft. from N. Line

_____ Ft. from S. Line

330 Ft. from E. Line

_____ Ft. from W. Line

SECTION PLAT

	0		

Location _____

Rig up _____

Drilling and Remarks:

P.B. 3314
6000 and
Pot- 315

RECORD

Cased 6 in. 3286 ft.Sand 511 3286

Gas _____

Oil _____

Total Depth 3316

PRODUCTION

1st 24 hrs. Nat. _____

1st 24 hrs. after shot _____

Gas _____ Cu. Ft.

Dry Hole _____

Abandoned _____

Date

NOV 17 1937 19

H. D. Hatfield Scout