


Barton

Section 3 Township 20 Range 11-W
Well No. 1 Dick
Company Simpson & Noble et al

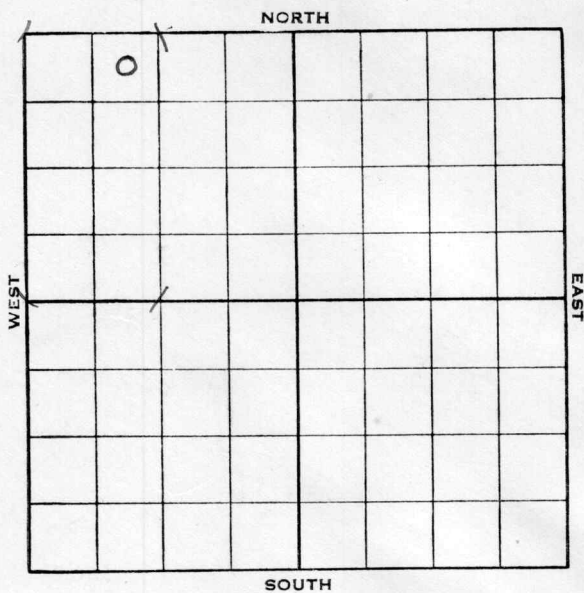


KANSAS

Barton

Sec. 3 Twp. 20 R. 11-WWell No. #1 Dick Farm
Simpson & Noble et al Company330 Ft. from N. Line Ft. from S. Line Ft. from E. Line990 Ft. from W. Line

Elev. 1777'.

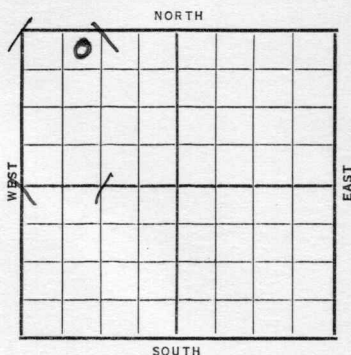

Date	REPORT
1938	
2/9	B.R.R.
2/18	12" @ 195'. Drlg. 1937'.
2/26	Lansing 3059'. Coring 3300'.
3/4	Arb. 3306 & 7". T.D. 3316'. 700' oil. Swab 2 oil per hour. Shot 20 qts.
3/11	T.D. 3320'. 2000 acid. Swab 5 oil per hr. Will reacidize.
3/18	2500 acid.
3/23	7" @ 3306'. Arb. 3306'. T.D. 3320'. Shot 20 qts. 2500 acid. Potential 258 bbls.
	COMPLETED

Barton KANSASMap No. _____ Sec. 3 Twp. 20 R. 11WWell No. 1 DickSimpson & Noble etal Company

Contractor _____

FIRST REPORT

NE NW NW

330 Ft. from N. Line

_____ Ft. from S. Line

_____ Ft. from E. Line

990 Ft. from W. Line**SECTION PLAT**

2			
/	/		

Location _____

Rig up _____

Drilling and Remarks:

BRR**RECORD**

Cased _____ in., _____ ft.

Sand _____

Gas _____

Oil _____

Total Depth 71**PRODUCTION**

1st 24 hrs. Nat. _____

1st 24 hrs. after shot _____

Gas _____ Cu. Ft.

Dry Hole _____

Abandoned _____

Date

FEB 9 1938 19H. D. Hatfield Scout

KANSAS

Barton

Map No. 46 Sec. 3 Twp. 20 R. 11WWell No. 1 DickSimpson & Noble etal Company

Contractor

COMPLETED

NE NW NW

330 Ft. from N. Line

_____ Ft. from S. Line

_____ Ft. from E. Line

990 Ft. from W. Line

SECTION PLAT

0			

Location _____

Rig up _____

Drilling and Remarks:

*Shot 20 gts**2500 acid**POT 258*

RECORD

Cased 7 in., 3306 ft.Sand 456 3306

Gas _____

Oil _____

Total Depth 3320

PRODUCTION

1st 24 hrs. Nat. _____

1st 24 hrs. after shot _____

Gas _____ Cu. Ft.

Dry Hole _____

Abandoned _____

Date

MAR 23 1938

19

H. D. Hatfield

Scout