

KANSAS

Section 3 Township 20 Range 11-W


Well No. #5 Dick

Company J. Bergman

NORTH

WEST

EAST

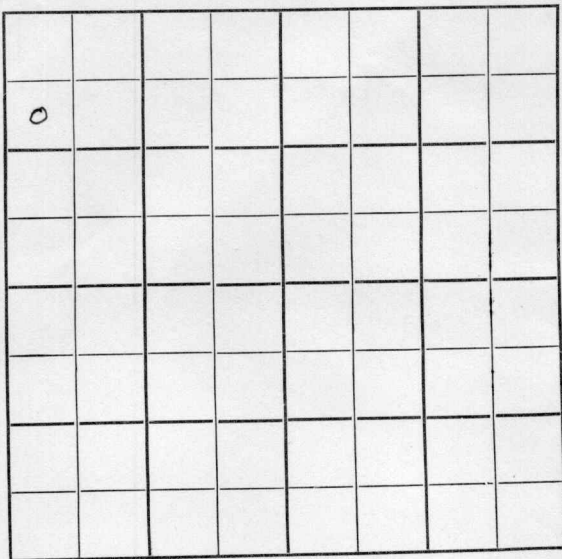

SOUTH

KANSAS

Barton

Sec. 3 Twp. 20 R. 11-W

Well No. #5 Dick Farm

J. Bergman Company

Honaker Contractor


990 Ft. from N. Line

 Ft. from S. Line

 Ft. from E. Line

330 Ft. from W. Line

SW NW NW

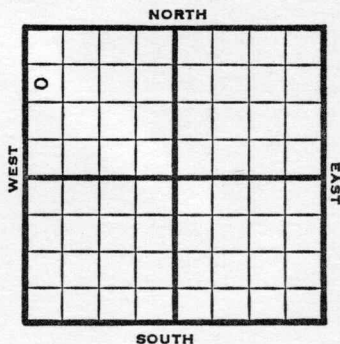

1950 Elev 1778

REPORT

6/7 Spuc 5-30-50
8" @ 155

Anhy 528-57

6/28 Drlg 2599
8" @ 155

Anhy 528-57

Arb 3312-15

5" @ 3315

TD 3325

800 acid

Comp 15 bopd

Completed

COMPLETED

Map No. _____ Sec. 3 Twp. 20 R. 11WWell No. 5 DickJ. Bergman _____ CompanyHonaker _____ Contractor

SW NW NW

E1.1778

SECTION PLAT

990 Ft. from N. Line

_____ Ft. from S. Line

_____ Ft. from E. Line

330 Ft. from W. Line

0			

FIRST REPORT

Barton

Location _____

Rig up _____

Drilling and Remarks:

Spud 5-30-50

8" @ 155

Anhy. 528-57

Drlg. 2599

RECORD

Cased _____ in., _____ ft.

Sand _____

Gas _____

Oil _____

Total Depth _____

PRODUCTION

1st 24 hrs. Nat. _____

1st 24 hrs. after shot _____

Gas _____ Cu. Ft.

Dry Hole _____

Abandoned _____

Date

JUN 7 1950 19

J. E. TYRA

Scout

Kansas

Map No. _____ Sec. 3 Twp. 20 R. 11WWell No. 5 DickBergman

Company

Contractor

SW NW NW

E1. 1778

SECTION PLAT

990 Ft. from N. Line

_____ Ft. from S. Line

_____ Ft. from E. Line

330 Ft. from W. LineBarton County

Location _____

Rig up _____

Drilling and Remarks:

8" @ 155

Anhy 528-57

Arb. 3312-15

5" @ 3315

TD 3325

800 acid

RECORD

Cased _____ in., _____ ft.

Sand _____

Gas _____

Oil _____

Total Depth 3325

PRODUCTION

1st 24 hrs. Nat. _____

1st 24 hrs. after shot _____

Gas _____ Cu. Ft.

Dry Hole _____

Abandoned _____

Comp. 15 bopd
Date

JUN 28 1950

19

J. E. TYRA Scout