

Barton KANSAS

Section 2 Township 20 Range 11-W

Well No. #12 A. E. Schartz

Company Stanolind

Silica Pool

NORTH

WEST

EAST

SOUTH

KANSAS

Barton

Sec. 2 Twp. 20 R. 11-WWell No. #12 A. E. Scharitz FarmStanolind Company

(Silica)


330 Ft. from N. Line

Ft. from S. Line

Ft. from E. Line

1320 Ft. from W. Line

Elev. 1768

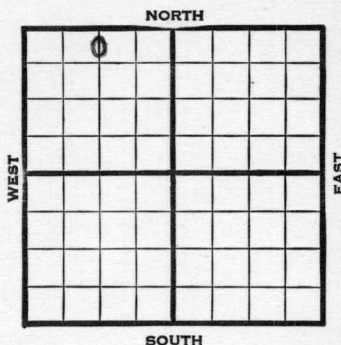

1939	REPORT
8/2	Location
8/10	"
8/17	"
8/24	Cellar.
8/31	10" - 228' WOC.
9/7	Anhy 490' Drlg. 3142'
9/14	Arb. 3286' 5" - 3284½'
	T.D. 3290' RUST.
9/21	T.D. 3296' 1000 acid.
	Pump 1 bbl. fluid, 65% water in 1 hour.
9/28	C. O.
10/4	Arb. 3286'
	5" - 3284½'
	T.D. 3301'
	3000 acid.
	Potential 189 bbls., pump.
	COMPLETED

Map No. _____ Sec. 2 Twp. 20 R. 11WWell No. 12 A. E. SchartzStanolind

Company

Contractor

FIRST REPORT

C N L N $\frac{1}{2}$ NW

SECTION PLAT

330 Ft. from N. Line

_____ Ft. from S. Line

_____ Ft. from E. Line

1320 Ft. from W. Line

SILICA POOL

Location X

Rig up _____

Drilling and Remarks:

RECORD

Cased _____ in., _____ ft.

Sand _____

Gas _____

Oil _____

Total Depth _____

PRODUCTION

1st 24 hrs. Nat. _____

1st 24 hrs. after shot _____

Gas _____ Cu. Ft.

Dry Hole _____

Abandoned _____

Date

AUG 2 1939

19

S. J. LEWIS

Scout

Barton

KANSAS

Map No. _____ Sec. 2 Twp. 20 R. 11WWell No. 12 A. E. ScharzStanolind

Company

Contractor

COMPLETED

C N L N $\frac{1}{2}$ NW330 Ft. from N. Line

_____ Ft. from S. Line

_____ Ft. from E. Line

1320 Ft. from W. Line

SECTION PLAT

SILICA POOL

Location _____

Rig up _____

Drilling and Remarks:

CR 83286
5" @ 3284 1/2
3000 acid

Pump 189 P.D.

RECORD

Cased _____ in., _____ ft.

Sand _____

Gas _____

Oil _____

Total Depth 3301

PRODUCTION

1st 24 hrs. Nat. _____

1st 24 hrs. after shot _____

Gas _____ Cu. Ft.

Dry Hole _____

Abandoned _____

Date

OCT 4 1939

19

S. J. LEWIS Scout