

KANSAS

Barton

Section 3 Township 20 Range 11W

Well No. 2 Panning

Company J. Bergman

Silica
NORTH

							0

WEST

EAST

SOUTH



Sec. 3 Twp. 20 R. 11W

Well No. #2 Panning Farm

J. Bergman Company


Silica Pool

990' Ft. from N. Line

_____ Ft. from S. Line

330' Ft. from E. Line

_____ Ft. from W. Line

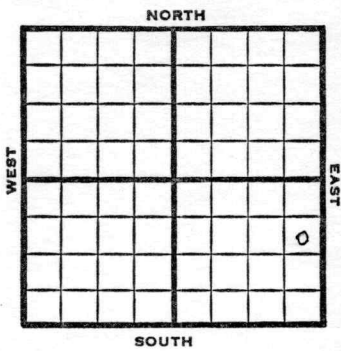

SE NE SE

1949	Elev 1764' REPORT
3/23	Location
3/30	8"@ 162' Drlg 3102'
4/6	Arbuckle 3286' TD 3287' 5" @ 3287'
4/13	TD 3294' Arb. 3286' 5"@ 3287' Pump 50 Oil Pot 42° Gr. Comp
COMPLETED	

Map No. _____ Sec. 3 Twp. 20 R. 11W

Well No. 2 Panning

J. Bergman Company

FIRST REPORT Contractor

SE NE SE

SECTION PLAT

990 Ft. from N. Line

_____ Ft. from S. Line

330 Ft. from E. Line

_____ Ft. from W. Line

Barton County

Location X

Rig up _____

Drilling and Remarks:

RECORD

Cased _____ in., _____ ft.

Sand _____

Gas _____

Oil _____

Total Depth _____

PRODUCTION

1st 24 hrs. Nat. _____

1st 24 hrs. after shot _____

Gas _____ Cu. Ft.

Dry Hole _____

Abandoned _____

Date

MAR 23 1949 19

S. J. LEWIS

Scout

Map No. 46 Sec. 3 Twp. 20 R. 11W

Well No. 2 Panning

J. Bergman Company

COMPLETE Contractor

SE NE SE

E11764

SECTION PLAT

990 Ft. from N. Line

_____ Ft. from S. Line

330 Ft. from E. Line

_____ Ft. from W. Line

Barton County

Location _____

Rig up _____

Drilling and Remarks:

Cor 43286
5' @ 3287
Prod 50 oil 25'

420/20

RECORD

Cased _____ in., _____ ft.

Sand _____

Gas _____

Oil _____

Total Depth 3294

PRODUCTION

1st 24 hrs. Nat. _____

1st 24 hrs. after shot _____

Gas _____ Cu. Ft.

Dry Hole _____

Abandoned _____

Date

APR 13 1949

19

S. J. LEWIS

Scout