


Map No. KANSAS Sec. 4 Twp. 20 R. 11W
 Well No. 1 State Farm
Durby et al Company

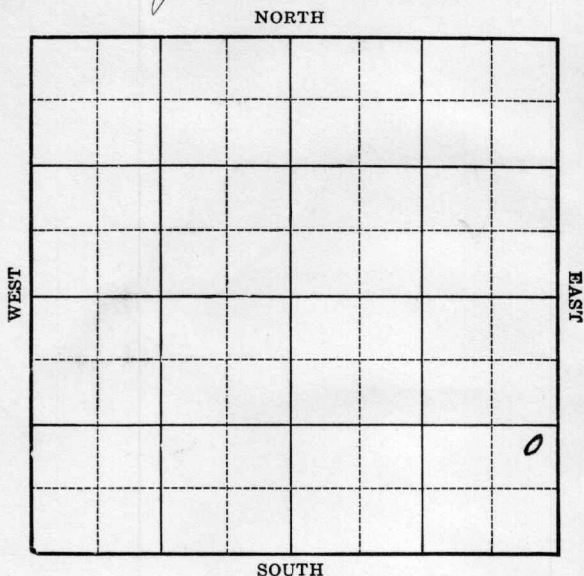

Location _____

Drilling Remarks _____

Rig Up _____

Drilling Remarks _____

RECORD

Cased _____ in. _____ ft.

Sand _____

Gas _____

Oil _____

Total Depth _____

PRODUCTION

1st 24 hrs. Nat. _____

1st 24 hrs. after shot _____

Gas _____ cu. ft. _____


Dry Hole _____

Abandoned _____

Barton

Map No. KANSAS Sec. 4 Twp. 20 R. 11W
Well No. 1 State State Farm _____
Curby et al Company _____

NORTH

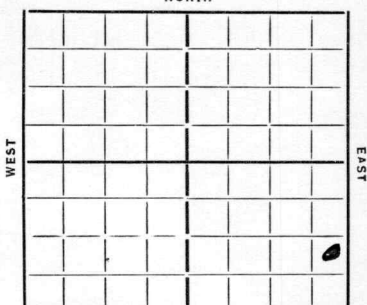

SOUTH

1775 Ft. from N. Line

_____ Ft. from S. Line

325 Ft. from E. Line

_____ Ft. from W. Line

Date

REPORT

1935
1/9 Location
1/17 — 1/24 — 1/31 — 2/7 —
2/14 — 2/21 —
2/28 Relg
3/7 Rig
3/14 — 3/21 —
3/28 Relg 900
4/4 " 2800
4/11 —
4/18 Relg 3275 KC 3062
4/26 Rel 3310 T7 3326 7" 3310
5/2 Rust
5/9 3368 500' water
5/16 PB 3360 1000 acid
5/22 Silicious 3310 T7 3368
170 ft.

ABANDONED

Map No. 46 Sec. 4 Twp. 20 R. 11WWell No. 1- StateDerby et al Company

Contractor

FIRST REPORTS

SECTION PLAT

			0

1775 Ft. from N. Line

Ft. from S. Line

325 Ft. from E. Line

Ft. from W. Line

Location ✓

Rig up

Drilling and Remarks:

RECORD

Cased _____ in., _____ ft.

Sand _____

Gas _____

Oil _____

Total Depth _____

PRODUCTION

1st 24 hrs. Nat. _____

1st 24 hrs. after shot _____

Gas _____ Cu. Ft.

Dry Hole _____

Abandoned _____

Date

1-9-35 192ORVAL MANNSCHRECK
Scout

Map No. 46 Sec. 4 Twp. 20 R. 11W

Well No. 1- State

Derby et al Company

Contractor

ABANDONED

SECTION PLAT

			0

1775 Ft. from N. Line

..... Ft. from S. Line

325 Ft. from E. Line

..... Ft. from W. Line

Location

Rig up

Drilling and Remarks:

RECORD

Cased in., ft.

Sand silicious 3310

Gas

Oil

Total Depth 3368

PRODUCTION

1st 24 hrs. Nat.

1st 24 hrs. after shot

Gas Cu. Ft.

Dry Hole

Abandoned

Date

5-22-35 192

ORVAL MANNSCHRECK

Scout