


Section 34 Township 18 Range 2 W

Well No. # 4 Foreman

Company Crest Pet. & Mid-Plains

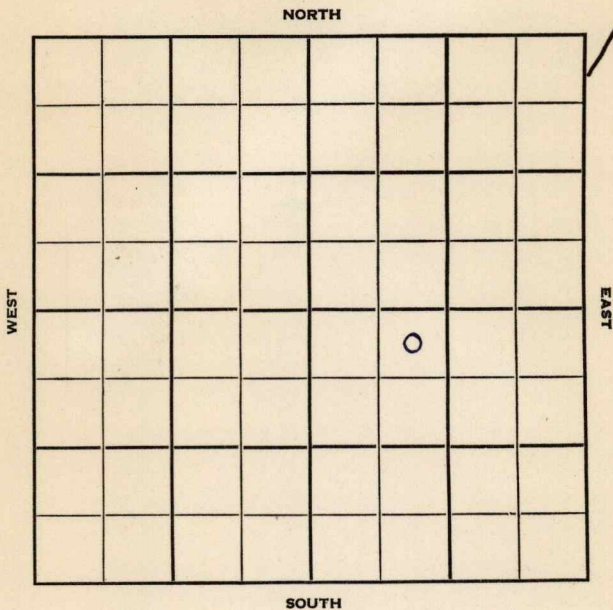

McPherson

KANSAS
2W

Sec. 34 Twp. 18 R. 2W

Well No. #4 Foreman Farm

Crest Pet. & Mid-Plains Company

Crest Pet. - Contr. Contractor

Wildcat


330' Ft. from N. Line

_____ Ft. from S. Line

_____ Ft. from E. Line

990' Ft. from W. Line

NE NW SE

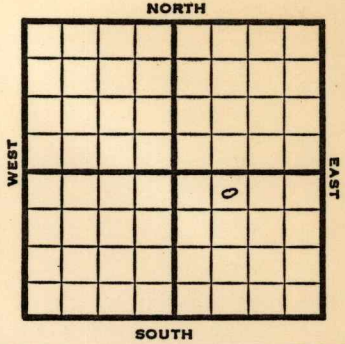

1951 **Elev. 1565'** REPORT

5/16 RUR

5/29 Spud 5-17-51
D&A TD 3003
8" @ 140
Lans. 2346 Miss 2954
TD 3003 D&A

ABANDONED

County McPherson State Kansas

Sec. 34 (Blk. 18) (Sur. Rge.) 2W Map No.

Operator Crest Pet. & Mid-Plains

Well No. 4 Farm Foreman

Elev. _____ Location NE NW SE



330 Ft. From N Line SE
990 Ft. From W Line Quarter

1st. Report MAY 16 1951

Completion _____

Remarks _____

Crest Pet. - Contr.

Spudding Date _____

Drlg. Data Wildcat

RUR

J. E. TYRA

County McPherson State Kansas

Sec. 34 (Blk. 18) (Sur. Rge.) 2W Map No.

Operator Crest Pet. & Mid-Plains

Well No. 4 Farm Foreman

Elev. 1565 Location NE NW SE



330 Ft. From N Line SE

990 Ft. From W Line Quarter

1st. Report

Completion MAY 29 1951

Remarks Wildcat

Crest Pet. - Contr.

Spudding Date 5-17-51

Drlg. Data D & A TD 3003

8" @ 140 Lans. 2346 Miss. 2954

TD 3003 D & A