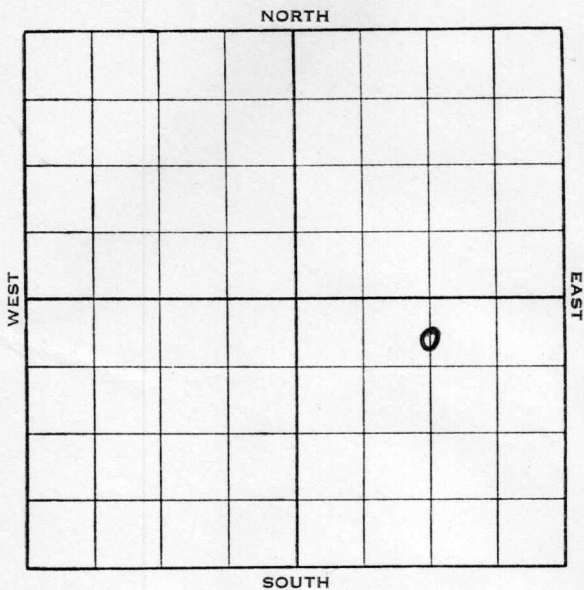


KANSAS

Barton

FORM 51 5M 2-38 TPCO.

Section 3 Township 20 Range 11-WWell No. #14 Fred PanningCompany Stanolind

1938

12/13 6" - 3298'.

Arb. 3291'.

T. D. 3313'.

P. B. 3305'.

4000 acid.

Potential 188 oil & 37 water.

COMPLETED

Barton

KANSAS

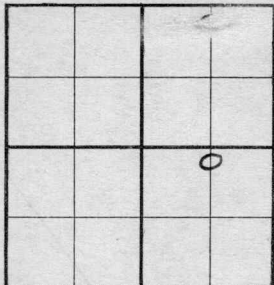
Map No. _____ Sec. 3 Twp. 20 R. 11WWell No. 14-Fred PanningStanolind

Company

FIRST REPORT

Contractor

C N L SE

SECTION PLAT440 Ft. from N. Line

_____ Ft. from S. Line

1320 Ft. from E. Line

_____ Ft. from W. Line

Location _____

Rig up _____

Drilling and Remarks:

RUR

RECORD

Cased _____ in., _____ ft.

Sand _____

Gas _____

Oil _____

Total Depth _____

PRODUCTION

1st 24 hrs. Nat. _____

1st 24 hrs. after shot _____

Gas _____ Cu. Ft.

Dry Hole _____

Abandoned _____

Date

OCT 26 1938

19

H. D. Hatfield

Scout

Barton

KANSAS

Map No. 46 Sec. 3 Twp. 20 R. 11WWell No. 14 Fred PanningStanolind

Company

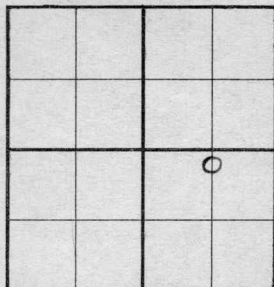
Contractor

COMPLETED

C N L SE

440 Ft. from N. Line Ft. from S. Line1320 Ft. from E. Line Ft. from W. Line

SECTION PLAT

Location Rig up

Drilling and Remarks:

*4000 acid.**POT 188 oil
37 wtr*

RECORD

Cased 6 in., 3298 ft.Sand Arb 3291Gas Oil Total Depth 3313

PRODUCTION

1st 24 hrs. Nat. 1st 24 hrs. after shot Gas Cu. Ft.Dry Hole Abandoned

Date

DEC 13 1938 19H. D. Hatfield Scout