


Section 3 Township 20 Range 11-W

Well No. #4 Chas. Rose

Company Stanolind

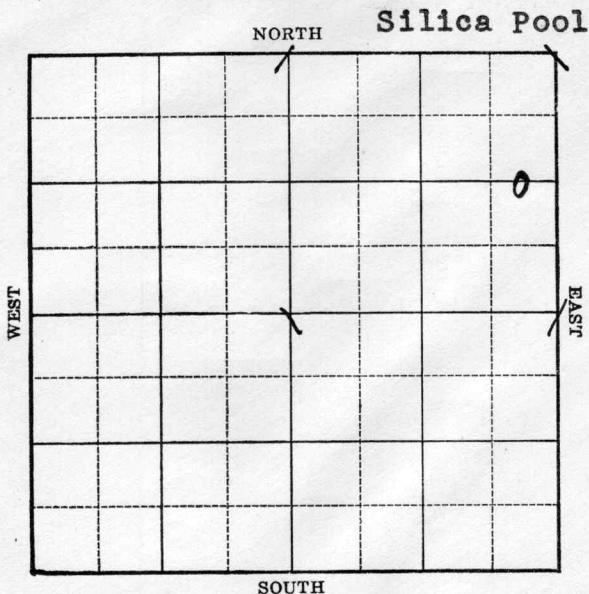

Barton

KANSAS

Map No. _____ Sec. 3 Twp. 20 R. 11WWell No. 4 Chas. RoseStanolind

Company

Contractor

FIRST REPORT


C E $\frac{1}{2}$ E $\frac{1}{2}$ NE1320 Ft. from N. Line

_____ Ft. from S. Line

330 Ft. from E. Line

_____ Ft. from W. Line

SECTION PLAT

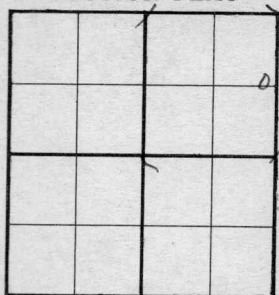

Silica Pool

Location X

Rig up _____

Drilling and Remarks:

RECORD

Cased _____ in., _____ ft.

Sand _____

Gas _____

Oil _____

Total Depth _____

PRODUCTION

1st 24 hrs. Nat. _____

1st 24 hrs. after shot _____

Gas _____ Cu. Ft.

Dry Hole _____

Abandoned _____

Date

JUL 5 1939

19

S. J. LEWIS

Scout

Map No. _____ Sec. 3 Twp. 20 R. 11WWell No. 4 Chas. RoseStanolind

Company

Contractor

COMPLETED

SECTION PLAT

1320 C $E\frac{1}{2}$ $E\frac{1}{2}$ NE
Ft. from N. Line

Ft. from S. Line

330 Ft. from E. Line

Ft. from W. Line

SILICA POOL

			0

Location _____

Rig up _____

Drilling and Remarks:

*Cr & 3283**5" C 3283**Pump 1378 ft.*

RECORD

Cased _____ in., _____ ft.

Sand _____

Gas _____

Oil _____

Total Depth 3287

PRODUCTION

1st 24 hrs. Nat. _____

1st 24 hrs. after shot _____

Gas _____ Cu. Ft.

Dry Hole _____

Abandoned _____

Date

AUG 2 1939 19

S. J. LEWIS

Scout