

Map No. **KANSAS** Sec. 35 Twp. 18^s 2^w
 Well No. 2 - Slinburg Farm
Texas Company

NORTH

		0					

3

WEST

EAST

SOUTH

Location.....

Drilling Remarks

.....

.....

.....

.....

.....

.....

.....

.....

.....

.....

Rig Up.....

Drilling Remarks

.....

.....

.....

.....

.....

.....

.....

.....

.....

.....

RECORD

Cased..... in..... ft.

Sand.....

Gas.....

Oil.....

Total Depth.....

PRODUCTION

1st 24 hrs. Nat.....

1st 24 hrs. after shot.....

Gas..... cu. ft.....

Dry Hole.....

Abandoned.....

Map No. Sec. Twp. R.

Well No. Farm


..... Company

..... Ft. from N. Line

..... Ft. from S. Line

..... Ft. from E. Line

..... Ft. from W. Line

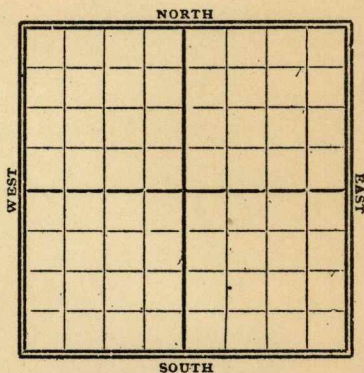

1928

Date

REPORT

Gypsy Records

4/11

79 gts 2340-45'

5 bbl show

TD 2378 Prod.

MAP No. _____ SEC. 38 TWP. 18S R. 2W

WELL No. 2 Clivestang
Deputy COMPANY _____

CONTRACTOR _____

SECTION PLAT

	o		

_____ FT. FROM N. LINE

_____ FT. FROM S. LINE

_____ FT. FROM E. LINE

_____ FT. FROM W. LINE

over

LOCATION _____

RIG UP _____

DRILLING AND REMARKS:

2340-45
79 qts - 5 lbs
show

RECORD

CASED _____ IN. _____ FT.

SAND _____

GAS _____

OIL _____

TOTAL DEPTH 2378

PRODUCTION

1ST 24 HRS. NAT. _____

1ST 24 HRS. AFTER SHOT _____

GAS _____ CU. FT.

DRY HOLE ☒

ABANDONED ☒

DATE

4/11 1928

SCOUT