

McPherson

KANSAS

SECTION 36 TOWNSHIP 18 RANGE 2 W

WELL NO. #1 Hill

COMPANY Rupp-Ferguson

NORTH

0							

SOUTH

WEST

EAST

5

McPherson

KANSAS

SEC. 36	TWP. 18	R. 2W
------------	------------	----------

WELL NO.

#1 Hill

FARM

COMPANY

Rupp-Ferguson

CONTRACTOR

Co. Tools

WILDCAT


Ft. from N. Line

Ft. from S. Line

Ft. from E. Line

Ft. from W. Line

SW SW NW

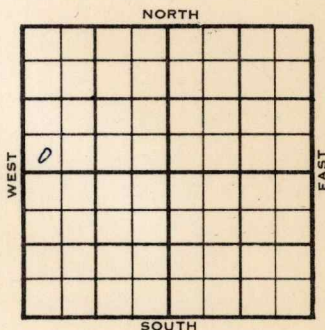

1955

ELEVATION

1573 RB

1570 DF

REPORT

11-23

Comm. 11-18-55

8" @ 156/115

Drlg. 2015

11-30

D & A

L. 2355'

Chat 2972

TD 3000'

ABANDONED

County McPherson Elev. 1570 DF 1573
Sec. 36 Twp. 18 Rge. 2W
Company Pupp-Ferguson
Farm Name Hill No. 1

TOPS	DEPTH	LOG	DATUM	Loc. in Sec.
Anh.				SW SW NW
Tp.				
H.				
Tr.				
Dg.				
B.L.				
L.				
K.C.				Geol.
B.K.C.				Contr.
Ce.				Co. tools
C.				
M.				Pool
M.				Wildcat
K.				
Mz.				
Mq.				
V.				
S.				
S.				
A.				
R.				
Pe.				
G.				
T.D.				

0 NOV 23 '55

FIRST-REPORT

Date Comm. 11-18-55
8" @ 156/115 drlg. 2015

Lse.
No.
Sec.
T.
R.

