
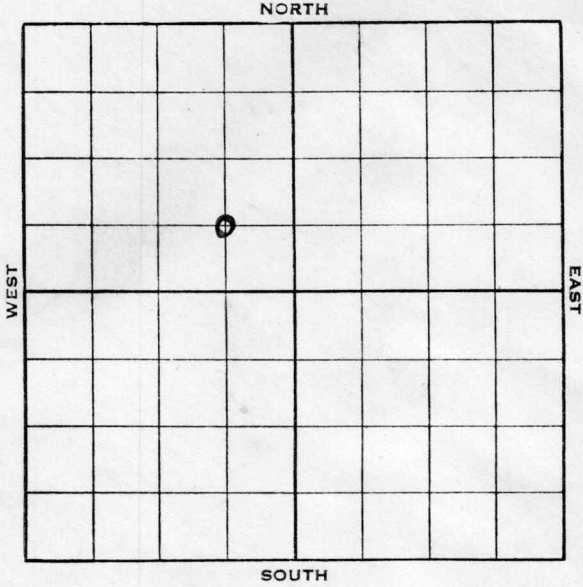


Section **5** Township **20** Range **11-W**

Well No. **#1 Soeken**

Company **Stanolind**

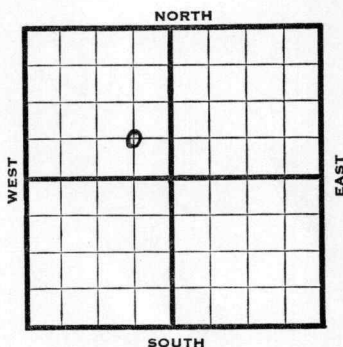

Sec. 5 Twp. 20 R. 11-WWell No. #1 Soeken Farm  
Stanolind Company         Ft. from N. Line660 Ft. from S. Line660 Ft. from E. Line         Ft. from W. Line

Elev. 1778

1938	REPORT
5/10	R U R
5/20	10" @ 197'. Anhy 534'. Drlg. 2138'.
5/27	Lans. 3078'.. Cong. 3312'. Arb. 3323' S.O. Coring 3329'.
6/3	T.D. 3338'. 6" at 3324'. Shot 10 qts. Cleaning out.
6/10	Swab 1 bbl. oil per hr. 1600 acid. Swab 6 oil in 3 hrs. 2000 acid. Swab 36 oil in 3 hrs 3000 acid.
6/15	6" @ 3324'. Arb. 3323'. T.D. 3338'. 6600 acid. Shot 10 qts. Potential 443 bbls. No water.
	COMPLETED

Map No. 46 Sec. 5 Twp. 20 R. 11W

Well No. 1 Soeken

Stanolind

Company

Contractor

FIRST REPORT

C SE NW

SECTION PLAT



\_\_\_\_\_ Ft. from N. Line

660 Ft. from S. Line

660 Ft. from E. Line

\_\_\_\_\_ Ft. from W. Line

*Drill site  
375 acres north of River*

Location \_\_\_\_\_

RECORD

Cased \_\_\_\_\_ in., \_\_\_\_\_ ft.

Sand \_\_\_\_\_

Gas \_\_\_\_\_

Oil \_\_\_\_\_

Total Depth \_\_\_\_\_

PRODUCTION

1st 24 hrs. Nat. \_\_\_\_\_

1st 24 hrs. after shot \_\_\_\_\_

Gas \_\_\_\_\_ Cu. Ft.

Dry Hole \_\_\_\_\_

Abandoned \_\_\_\_\_

Drilling and Remarks:

**RUR**

Date

MAY 10 1938 19

H. D. Hatfield Scout

Barton KANSAS

Map No. 46 Sec. 5 Twp. 20 R. 11W

Well No. 1 Soeken

Stanolind

Company

Contractor

**COMPLETED**

**SECTION PLAT**

C SE NW

\_\_\_\_\_ Ft. from N. Line

660 Ft. from S. Line

660 Ft. from E. Line

\_\_\_\_\_ Ft. from W. Line

	0		

Location \_\_\_\_\_

Rig up \_\_\_\_\_

Drilling and Remarks:

*6600 Acid  
Shot 10 gts  
POT 443  
no wtr*

**RECORD**

Cased 6 in., 3324 ft.

Sand ARB 3323

Gas \_\_\_\_\_

Oil \_\_\_\_\_

Total Depth 3338

**PRODUCTION**

1st 24 hrs. Nat. \_\_\_\_\_

1st 24 hrs. after shot \_\_\_\_\_

Gas \_\_\_\_\_ Cu. Ft.

Dry Hole \_\_\_\_\_

Abandoned \_\_\_\_\_

Date

JUN 15 1938

19

H. D. Hatfield Scout